

JACKSON MISSISSIPPI BOARD OF WATER COMMISSIONERS

K 79

*can't locate*

5-11-64

3772 WATER WELL DRILLERS LOG

**CODED**

Date: 5-11, 1964, Driller: Hattiesburg Butere County Jackson  
(Name)

(1) Owner of Land: Superior Gas Co  
(Name)  
Vareleave Miss.  
(Address)

(2) Location: 1/4, 1/4, Sec. 16 T 6 R 7  
(distance) (direction) (Nearest Town)

(3) Topography:  (Hilly)  (Flat)  (Level)

(4) Purpose of Well: industrial  
(Domestic Irrigation Municipal, Industrial, Other)

Description & Color of Materials Sand, Clay, Red Clay, Shell, etc.	Thick- ness Feet	Depth Feet
<u>yellow clay</u>	<u>0-8</u>	
<u>yellow sand</u>	<u>8-32</u>	
<u>white clay</u>	<u>32-38</u>	
<u>Blue clay</u>	<u>38-45</u>	
<u>yellow sand</u>	<u>45-125</u>	
<u>Blue clay</u>	<u>125-180</u>	
<u>Blue sand</u>	<u>180-202</u>	

Information upon completion of well:

(1) Diameter 2 inches.

(2) Total Depth 202 feet.


(3) Water Level 12' ~~13'~~ feet below top of ground.

(4) Cased to \_\_\_\_\_, Size \_\_\_\_\_

(5) Screen: Size 2", Length 20'

(6) Were any formations sealed against pollution?  
 \_\_\_\_\_ yes,  no.

**CODED**

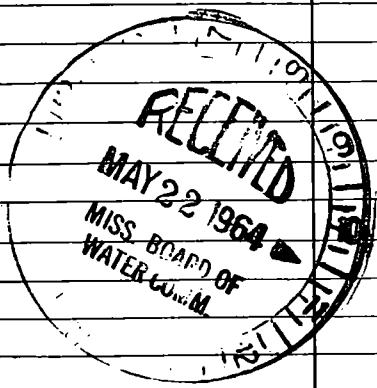

If YES depth of formation \_\_\_\_\_

Why \_\_\_\_\_

Drillers Remarks: \_\_\_\_\_

Well No.

(Use Back Side)

