

K80

9-8-64

K will locate

WATER WELL DRILLERS LOG

**CODED**

3751

Date: 9-8-64, 19\_\_\_, Driller: C. T. SWITZER WELL CO. County: Jackson

(Name)

(1) Owner of Land: Harold Vincent

(Name)

Rt 2 Box 274A Vandevosses Miss

(Address)

(2) Location: \_\_\_ 1/4, \_\_\_ 1/4, Sec. 9 6 7

T R

\_\_\_ miles, of \_\_\_

(distance) (direction) (Nearest Town)

(3) Topography:  (Hilly)  (Flat)  (Level)

(4) Purpose of Well: Domestic  
(Domestic Irrigation, Municipal, Industrial, Other)

Information upon completion of well:

(1) Diameter 2 inches.

(2) Total Depth 866 feet.

(3) Water Level 317 feet below top of ground.

(4) Cased to 866', Size 2"

(5) Screen: Size 2", Length 8ga 40'

(6) Were any formations sealed against pollution?


yes, \_\_\_ no.

If YES depth of formation: \_\_\_

Why Health Dept Requirements

Drillers Remarks: \_\_\_

Description & Color of Materials Sand, Clay, Red Clay, Shell, etc.	Thick- ness Feet	Depth Feet
Clay	0	12
Sand	12	46
Sand streaks	46	69
Clay	69	91
Clay + sand streaks	91	112
Clay	112	222
Sand fine	222	264
Sand fair	264	285
Clay + sand streaks	285	306
Clay	306	317
Sand	317	325
Clay	325	329
Sand streaks	329	351
Clay	351	356
Sand	356	372
Sand, fine	372	394
Clay	394	434
Clay + sand streaks	434	455
Clay + shale	455	476
Clay	476	564
Clay + shale	564	609
Clay	609	631
Shale	631	651
Sand fair	651	672
Sand, good	672	702
Clay	702	715
Sand streaks	715	737
Clay	737	782
Sand streaks	782	801
Sand, good	801	866

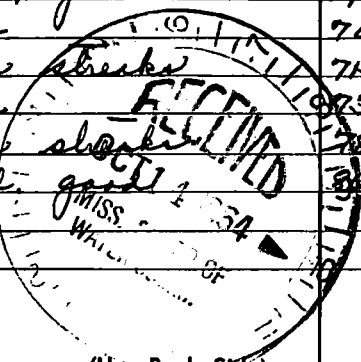

(Use Back-Side)

Well No.

