

JACKSON

CODED

K9Z

WATER WELL DRILLERS LOG

12-11-64

Date: 12-11, 1964, Driller: Jay Latt, County Jackson

Superstone Gas Co. (Name)

(1) Owner of Land: J. D. Smith (Name)

Description & Color of Materials Sand, Clay, Red Clay, Shell, etc. Thickness Feet Depth Feet

(Address) Vanclave

0-12	yc		
12-40	yc		
40-55	ws		
55-120	wc		
120-155	ws		
155-170	yc		
170-195	cs		

(2) Location: 1/4, 1/4, Sec. 16 T. 6 R. 7

5 miles S of Vanclave (distance) (direction) (Nearest Town)

(3) Topography: (Hilly) (Flat) (Level)

(4) Purpose of Well: Domestic (Domestic Irrigation Municipal, Industrial, Other)

CODED

Information upon completion of well:

(1) Diameter 2 inches.

(2) Total Depth 195 feet.

(3) Water Level 20 feet below top of ground.

(4) Cased to, Size.


(5) Screen: Size 2, Length 10 ft.

(6) Were any formations sealed against pollution? yes, no.

If YES depth of formation.

Why.

Drillers Remarks:

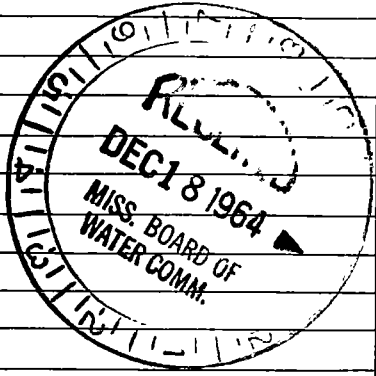

(Use Back Side)

Well No.

7

1948

10

[The remainder of the page contains extremely faint and illegible text, likely bleed-through from the reverse side of the document.]