

K 83

WATER WELL DRILLERS LOG

CODED

4-30-66 3781

Date: 4/30, 1966, Driller: Hattiesburg Butane County JACKSON
(Name)

(1) Owner of Land: S.T. Holden
(Name)
Wanleave
(Address)

(2) Location: 1/4, 1/4, Sec. 25 T 6 R 7
Wanleave area
miles (distance), of (direction), of (Nearest Town)

(3) Topography: X
(Hilly) (Flat) (Level)


(4) Purpose of Well: Domestic
(Domestic Irrigation, Municipal, Industrial, Other)

Description & Color of Materials Sand, Clay, Red Clay, Shell, etc.	Thick- ness Feet	Depth Feet
<u>Red sand</u>	<u>0-130</u>	
<u>Gray sand</u>	<u>130-140</u>	

CODED

Information upon completion of well:

- (1) Diameter 2' inches.
- (2) Total Depth 140 feet.
- (3) Water Level 19' feet below top of ground.
- (4) Cased to _____, Size _____
- (5) Screen: Size 2", Length 10'
- (6) Were any formations sealed against pollution?
_____ yes, X no.

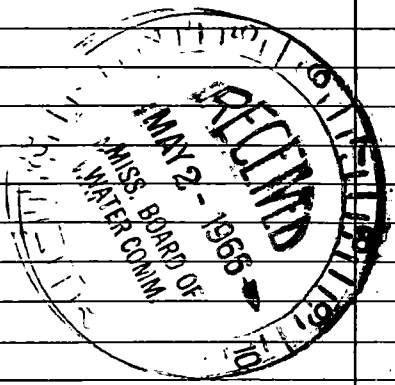

If YES depth of formation _____
Why _____
Drillers Remarks: _____

(Use Back Side)

Well No.

