

JACKSON

K87

4-15-71

MISSISSIPPI  
 BOARD OF WATER COMMISSIONERS  
 416 North State Street  
 Jackson, Mississippi 39201

**CODED**

WATER WELL DRILLERS LOG

4-13  
date well completed

1971 Coast Water Well Service  
firm name

Jackson  
county well located

LANDOWNER	description of formations encountered	from	to
Mack Anahietta			
Rt. 4 Box 222	top soil + clay	0	14
Ocean Springs, Miss. (mailing address)	sand - med. to coarse	14	32

WELL LOCATION:

sec. 13 T 6 N R 7 W  
 S  
3 miles E. of Umanlee  
 (distance) (direction) (nearest town)

blue clay	32	195
sand - med. to coarse	195	231

WELL PURPOSE: home  
(home, irrigation, municipal, industrial)

WELL COMPLETION DATA:

- (1) diameter (inches) 2"
- (2) total depth (feet) 231
- (3) static water level (feet) 45 below top of ground.
- (4) casing galv. (material), 221' (depth)  
2" (size) if telescope see back.
- (5) screen 10' (length), 221 (depth to top)  
2" (size), stainless steel (material)
- (6) pump 1 (HP), 12 (yield gpm)  
elec. (type power)
- (7) electric log NO (yes or no)  
(organization running log)

**CODED**

(8) how well bottom plugged barrel with valve


DRILLERS REMARKS:

MAY 5 - 1971

MISS. Bd. of WATER COMMISSIONERS

If well telescopes please sketch and show depths.

GROUND LEVEL

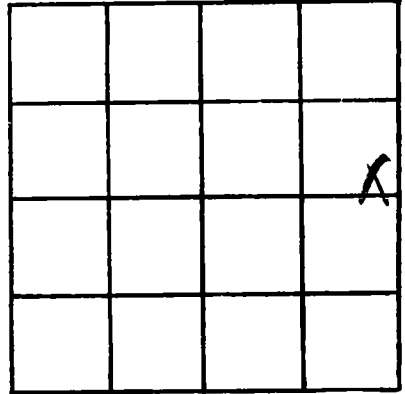

SECTION 13

Please indicate well location X.

ADDITIONAL INFORMATION

If more than one screen, show locations of each on sketch.