

JACKSON  
K 92  
10-26-71

MISSISSIPPI  
BOARD OF WATER COMMISSIONERS  
416 North State Street  
Jackson, Mississippi 39201

WATER WELL DRILLERS LOG

**CODED**  
MISS. BO. OF  
WATER COM.

Oct 26 1971 Calville W. S. Jackson  
date well completed firm name county well located

LANDOWNER: W. H. Collow  
Vanclave  
(mailing address)

WELL LOCATION:  
sec. 2 T. 6 N. R. 2 E  
3 miles NE of Vanclave  
(distance) (direction) (nearest town)

description of formations encountered	from	to
clay	0	20
sand	20	55
clay	55	80
sandy clay & sand	80	144
clay	144	227
sand	227	237
clay	237	392
sand	392	401

WELL PURPOSE: home  
(home, irrigation, municipal, industrial)

WELL COMPLETION DATA:

(1) diameter (inches) 2

(2) total depth (feet) 401

(3) static water level (feet) 80 below above top of ground.

(4) casing SAU 391  
(material) (depth)  
if telescope see back.  
(size)

(5) screen 10' 391  
(length) (depth to top)  
2" Stainless  
(size) (material)

(6) pump 1 1/2 11  
(HP) (yield gpm)  
elec  
(type power)

(7) electric log no  
(yes or no)  
(organization running log)


(8) how well bottom plugged BPI valve

**CODED**

DRILLERS REMARKS:

If well telescopes please sketch and show depths.

GROUND LEVEL

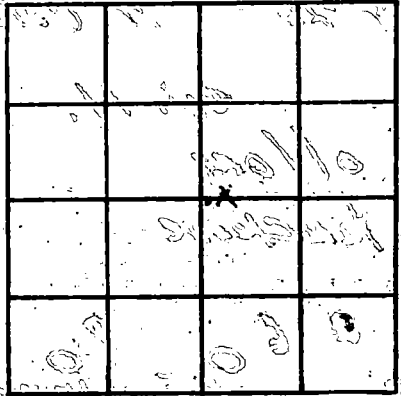

SECTION 2

Please indicate well location X:

ADDITIONAL INFORMATION

If more than one screen, show locations of each on sketch.