

JACKSON
K95
6-14-72

MISSISSIPPI
BOARD OF WATER COMMISSION
416 North State Street
Jackson, Mississippi 39201

CODF

WATER WELL DRILLERS LOG

6-14 1972 J.T. WARD WATER WELLS Jackson
date well completed firm name county well located

LANDOWNER: Grey Killeen
Humphrey Farm Rd
Ocean Springs, Miss
(mailing address)

description of formations encountered	from	to
top soil & clay	0	16'
sand	16'	28'
gray clay	28'	45'
sand	45'	57'
clay	57'	82'
sandy clay	82'	136'
clay	136'	185'
sand	185'	225'

WELL LOCATION:
sec. 20 T. 6 N. R. 7 E. W
10 miles N of Ocean Springs
(distance) (direction) (nearest town)

WELL PURPOSE: None
(home, irrigation, municipal, industrial)

- WELL COMPLETION DATA:
- (1) diameter (inches) 2"
 - (2) total depth (feet) 225'
 - (3) static water level (feet) 37' ^{below} _{above} top of ground.
 - (4) casing 2" galv. 220'
(material) (depth)
 - _____ If telescope see back.
(size)
 - (5) screen 5" _____
(length) (depth to top)
 - 2" stainless steel
(size) (material)
 - (6) pump 1 7
(HP) (yield gpm)
 - Electric
(type power)
 - (7) electric log NO
(yes or no)
 - _____ (organization running log)
 - (8) how well bottom plugged B/W

CODED


AUG - 7 1972

MISS. STATE

DRILLERS REMARKS:

If well telescopes please sketch and show depths.

GROUND LEVEL

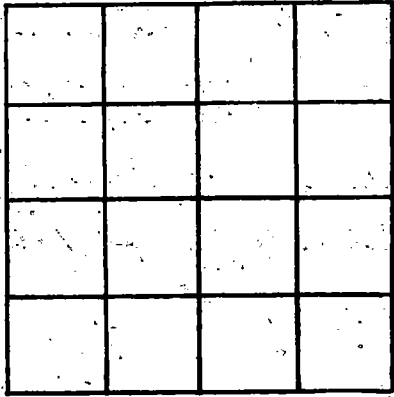

SECTION _____

Please indicate well location X.

ADDITIONAL INFORMATION

If more than one screen, show locations of each on sketch.