

**JACKSON**  
**K 106**  
**1-5-73**

MISSISSIPPI  
 BOARD OF WATER COMMISSIONERS  
 416 North State Street  
 Jackson, Mississippi 39201

**CODED**

**WATER WELL DRILLERS LOG**

1/5 19 73 Coast water well service Jackson  
 date well completed firm name county well located

LANDOWNER: Woody McMillian  
Pt. 4  
Ocean Springs, Ms  
 (mailing address)

description of formations encountered	from	to
<u>Top Soil</u>	<u>0</u>	<u>21</u>
<u>Fine sand</u>	<u>21</u>	<u>42</u>
<u>fine sand to Blue Clay</u>	<u>42</u>	<u>63</u>
<u>Med Sand</u>	<u>63</u>	<u>84</u>
<u>Med- to Coarse sand</u>	<u>84</u>	<u>105</u>
<u>Coarse sand</u>	<u>105</u>	<u>126</u>

WELL LOCATION:  
 sec. 23 T. 6 N. R. 7 W.  
3 miles S.E. of Vandeventer  
 (distance) (direction) (nearest town)

WELL PURPOSE: Home  
 (home, irrigation, municipal, industrial)

WELL COMPLETION DATA:  
 (1) diameter (inches) 2"  
 (2) total depth (feet) 122'  
 (3) static water level (feet) 30' (below above)  
 top of ground.  
 (4) casing P.V.C., 112'  
 (material) (depth)  
2" if telescope see back.  
 (size)  
 (5) screen 10', 112'  
 (length) (depth to top)  
2", P.V.C.  
 (size) (material)  
 (6) pump 1/2, 8  
 (HP) (yield gpm)  
electric  
 (type power)  
 (7) electric log No  
 (yes or no)  
 (organization running log)

**CODED**

(8) how well bottom plugged  
backwash valve


DRILLERS REMARKS:

JAN 25 1973

If well telescopes please sketch and show depths.

02010

GROUND LEVEL

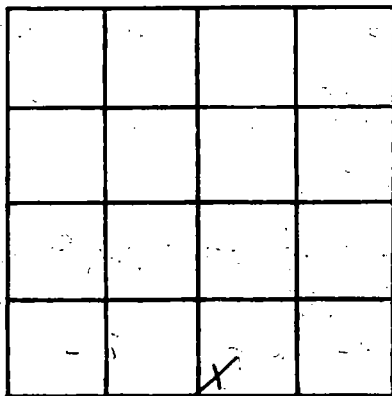

SECTION 23

Please indicate well location X.

ADDITIONAL INFORMATION

If more than one screen, show locations of each on sketch.