

JACKSON
K 109
6-26-73

MISSISSIPPI
BOARD OF WATER COMMISSIONERS
416 North State Street
Jackson, Mississippi 39201

CODED

WATER WELL DRILLERS LOG

9/26 1973 COAST WATER WELL SERVICE Jackson
date well completed firm name county well located

LANDOWNER: Tracy Green
RT 4
Ocean Springs, Ms.
(mailing address)
WELL LOCATION:
sec. 20 T. 6 S. R. 7 W.
2 1/2 miles SW of Hanahan
(distance) (direction) (nearest town)

description of formations encountered	from	to
<u>top soil</u>	<u>0</u>	<u>10</u>
<u>yellow clay</u>	<u>10</u>	<u>25</u>
<u>fine sand</u>	<u>25</u>	<u>50</u>
<u>Blue clay</u>	<u>50</u>	<u>70</u>
<u>med. sand</u>	<u>70</u>	<u>90</u>

WELL PURPOSE: Home
(home, irrigation, municipal, industrial)

<u>fine to coarse sand + gravel</u>	<u>90</u>	<u>187</u>
-------------------------------------	-----------	------------

WELL COMPLETION DATA:

- (1) diameter (Inches) 2"
- (2) total depth (feet) 380'
- (3) static water level (feet) 55 below top of ground ~~above~~
- (4) casing Pvc, 370',
(material) (depth)
2" If telescope see back.
(size)
- (5) screen 10', 370'
(length) (depth to top)
2", Pvc
(size) (material)
- (6) pump 1, 9
(HP) (yield gpm)
elec.
(type power)
- (7) electric log NO
(yes or no)

(organization running log)

<u>Blue clay</u>	<u>187</u>	<u>340</u>
<u>fine to coarse sand</u>	<u>340</u>	<u>380</u>

CODED


(8) how well bottom plugged B.W. Value

JUL 9 1973

DRILLERS REMARKS:

If well telescopes please sketch and show depths.

GROUND LEVEL

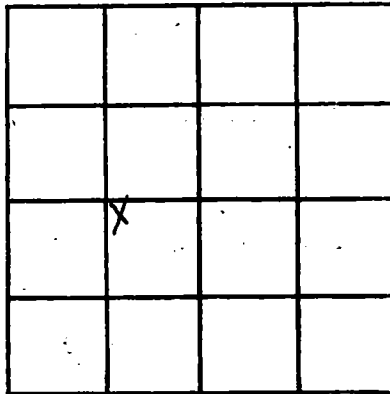

SECTION 20

Please indicate well location X.

ADDITIONAL INFORMATION

If more than one screen, show locations of each on sketch.