

CODED

MISSISSIPPI
BOARD OF WATER COMMISSIONERS
416 North State Street
Jackson, Mississippi 39201

WATER WELL DRILLERS LOG

COAST WATER WELL SERVICE

JACKSON

K 110

6-28-73

6/28 1973
date well completed

firm name


Jackson
county well located

LANDOWNER:	description of formations encountered	from	to
KENNETH EGGLE Rt. 4 Ocean Springs, Ms. (mailing address)	top soil	0	15
WELL LOCATION: sec. 22 T. 6 N. R. 7 W. S W 2 miles SW of Vancleave (distance) (direction) (nearest town)	Blue clay Fine sand Blue clay med. to coarse sand + gravel Blue clay med. to coarse sand Sand	25 55 80 105 190 330	55 80 105 190 370
WELL PURPOSE: Home (home, irrigation, municipal, industrial)			
WELL COMPLETION DATA: (1) diameter (inches) 2" (2) total depth (feet) 370' (3) static water level (feet) 55 below top of ground. (4) casing P.V.C. 360' (material) (depth) 2" If telescope see back. (size) (5) screen 10' 360' (length) (depth to top) 2" P.V.C. (size) (material) (6) pump 1 HP 9 (yield gpm) elec. (type power) (7) electric log NO (yes or no) (organization running log) (8) how well bottom plugged B.W. Valve			
DRILLERS REMARKS:			

CODED

If well telescopes please sketch and show depths.

GROUND LEVEL

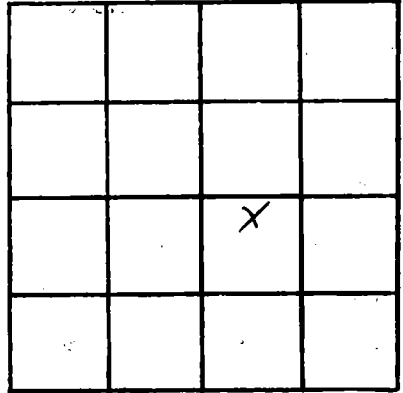

SECTION 20

Please indicate well location X.

ADDITIONAL INFORMATION

If more than one screen, show locations of each on sketch.