

JACKSON  
 Kill  
 7-1-73

MISSISSIPPI  
 BOARD OF WATER COMMISSIONERS  
 416 North State Street  
 Jackson, Mississippi 39201

**CODED**

WATER WELL DRILLERS LOG

7/1 1973 COAST WATER WELL SERVICE Jackson  
 date well completed firm name county well located

LANDOWNER: A. M. McVea  
Rt. 2 Box 341  
Ocean Springs Ms.  
 (mailing address)

description of formations encountered	from	to
Top soil	0	12
coarse sand	12	90
Blue Clay	90	245
fine to coarse sand	245	270

WELL LOCATION:  
 sec. 9 T. 6 N. R. 7 E  
 in Vanclave, Ms.  
 (distance) miles (direction) of (nearest town)

WELL PURPOSE: Home  
 (home, irrigation, municipal, industrial)

WELL COMPLETION DATA:

(1) diameter (inches) 2"

(2) total depth (feet) 270'

(3) static water level (feet) 12 below top of ground

(4) casing PVC, 260'  
 (material) (depth)  
2" if telescope see back.  
 (size)

(5) screen 10', 260'  
 (length) (depth to top)  
2", PVC  
 (size) (material)

(6) pump 1/2 8  
 (HP) (yield gpm)  
elec.  
 (type power)

(7) electric log NO  
 (yes or no)  
 (organization running log)

(8) how well bottom plugged NO  
B.W. Value


**CODED**

DRILLERS REMARKS:

JUL 9 1973

If well telescopes please sketch and show depths.

GROUND LEVEL

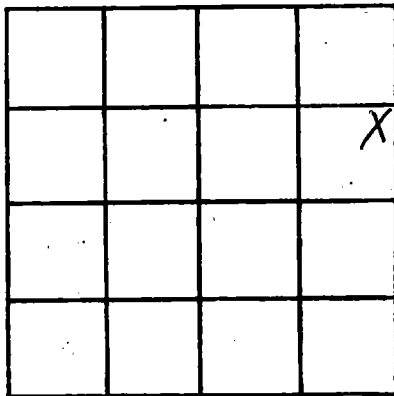

SECTION 9

Please indicate well location X.

ADDITIONAL INFORMATION

If more than one screen,  
show locations of each on sketch.