

K 113
 JACKSON
 7-28-73

MISSISSIPPI
 BOARD OF WATER COMMISSIONERS
 416 North State Street
 Jackson, Mississippi 39201

CODED

WATER WELL DRILLERS LOG

28 July 1973 Garland WATER WELLS JACKSON
 date well completed firm name county well located

LANDOWNER: H D HARGER
RFD Vandervee, Miss
(HUMPHREY FARMS)
 (mailing address)

WELL LOCATION:
 sec. 20 T. 6 S. R. 7 W.
2 miles SW of VANCLUE
 (distance) (direction) (nearest town)

WELL PURPOSE: Home
 (home, irrigation, municipal, industrial)

- WELL COMPLETION DATA:
- (1) diameter (inches) 9
 - (2) total depth (feet) 328
 - (3) static water level (feet) 52 below above top of ground.
 - (4) casing Gal. Steel, 368
 (material) (depth)
2" If telescope see back.
 (size)
 - (5) screen 10', 378-368
 (length) (depth to top)
2", Stainless Steel
 (size) (material)
 - (6) pump 1 (HP) 11 (yield gpm)
Electric
 (type power)
 - (7) electric log No
 (yes or no)
N/A
 (organization running log)
 - (8) how well bottom plugged Back
wash Valve

description of formations encountered	from	to
Red Clay	0	35
Mud + Sand	35	48
Sand	48	176
Hard Clay	176	191
Silt Clay	191	198
Hard Clay	198	201
Sand	201	207
Hard Clay	207	209
Sand - Fine	209	237
Mud	237	260
Hard Clay	260	294
Sand - Fine	294	308
Clay	308	310
Coarse Sand	310	378


CODED

DRILLERS REMARKS:

AUG 28 1973

If well telescopes please sketch and show depths.

GROUND LEVEL

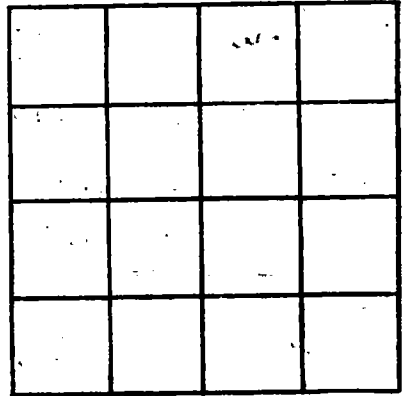

SECTION _____

Please indicate well location X.

ADDITIONAL INFORMATION

If more than one screen, show locations of each on sketch.