

Jackson  
K 114  
8-28-73

MISSISSIPPI  
BOARD OF WATER COMMISSIONERS  
416 North State Street  
Jackson, Mississippi 39201

**CODED**

WATER WELL DRILLERS LOG  
COAST WATER WELL SERVICE

8/28 1973 date well completed      Jackson firm name      Jackson county well located

LANDOWNER: James Reynolds  
Jackson Co. Courthouse  
Pascagoula Mo.  
(mailing address)

description of formations encountered	from	to
<u>Red clay</u>	<u>0</u>	<u>21</u>
<u>fine sand</u>	<u>21</u>	<u>64</u>
<u>Blue clay</u>	<u>64</u>	<u>86</u>
<u>Coarse sand</u>	<u>86</u>	<u>172</u>
<u>Blue clay</u>	<u>172</u>	<u>301</u>
<u>Coarse sand</u>	<u>301</u>	<u>386</u>

WELL LOCATION:  
sec. 20 T-6 S R-7 E  
2 1/2 miles S of Wrenchburg  
(distance) (direction) (nearest town)

WELL PURPOSE: None  
(home, irrigation, municipal, industrial)

- WELL COMPLETION DATA:
- (1) diameter (inches) 2"
  - (2) total depth (feet) 386'
  - (3) static water level (feet) 60 below above top of ground.
  - (4) casing P.V.C. 376'  
(material) (depth)  
2" if telescope see back.  
(size)
  - (5) screen 10 376  
(length) (depth to top)  
2" P.V.C.  
(size) (material)
  - (6) pump 1 10  
(HP) (yield gpm)  
elec.  
(type power)
  - (7) electric log no  
(yes or no)
  - (organization running log)
  - (8) how well bottom plugged B.W. Valve

**CODED**


SEP 21 1973

MISS. BC. OF  
WATER COMMISSIONERS

DRILLERS REMARKS:

If well telescopes please sketch and show depths.

GROUND LEVEL

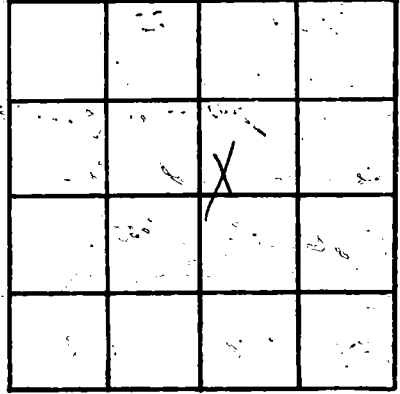

SECTION 20

Please indicate well location X.

ADDITIONAL INFORMATION

If more than one screen, show locations of each on sketch.