

JACKSON  
K 122  
10-9-73

MISSISSIPPI  
BOARD OF WATER COMMISSIONERS **CODED**  
416 North State Street  
Jackson, Mississippi 39201

WATER WELL DRILLERS LOG

10/9 1973 COAST WATER WELL SERVICE *Jackson*  
date well completed firm name county well located

LANDOWNER: *Lewis Norman*  
*Hattiesburg, Ms.*  
(mailing address)  
WELL LOCATION:  
sec. *38* T-*6* N R-*7* E  
S W  
*3* miles *SE* of *Tandem*  
(distance) (direction) (nearest town)  
WELL PURPOSE: *Comp*  
(home, irrigation, municipal, industrial)

description of formations encountered	from	to
<i>top soil</i>	<i>0</i>	<i>5</i>
<i>red clay</i>	<i>5</i>	<i>10</i>
<i>blue clay</i>	<i>10</i>	<i>30</i>
<i>coarse sand</i>	<i>30</i>	<i>64</i>
<i>white clay</i>	<i>64</i>	<i>71</i>
<i>coarse sand</i>	<i>71</i>	<i>130</i>


WELL COMPLETION DATA:  
(1) diameter (inches) *2"*  
(2) total depth (feet) *130'*  
(3) static water level (feet) *20* below above top of ground.  
(4) casing *PVC*, *120'*  
(material) (depth)  
*2"* If telescope see back.  
(size)  
(5) screen *10'*, *120'*  
(length) (depth to top)  
*2"*, *PVC*  
(size) (material)  
(6) pump *1/2*, *8*  
(HP) (yield gpm)  
*elec.*  
(type power)  
(7) electric log *NO*  
(yes or no)  
(organization running log)  
(8) how well bottom plugged *Backwash valve*

DRILLERS REMARKS:

NOV 7 1973

if well telescopes please sketch and show depths.

GROUND LEVEL

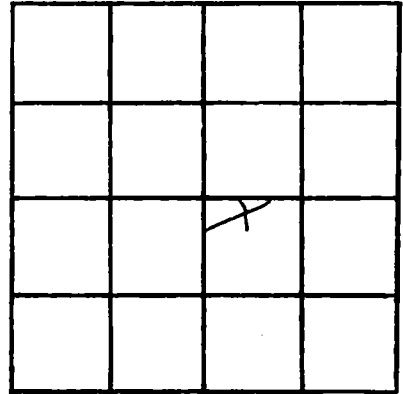

SECTION 38

Please indicate well location X.

ADDITIONAL INFORMATION

If more than one screen, show locations of each on sketch.