

JACKSON
K 125
10-18-73

MISSISSIPPI
BOARD OF WATER COMMISSIONERS
416 North State Street
Jackson, Mississippi 39201

CODED

WATER WELL DRILLERS LOG

Oct 18 1973 Cobville Water Sup. Jackson
date well completed firm name county well located

LANDOWNER: Robert
M^c Millan
Vanclaw Ms.
(mailing address)

description of formations encountered	from	to
clay	0	15
sand	15	153
clay	153	248
sand	248	260

WELL LOCATION:
sec. 14 T. 6 N R. 7 E
5 miles east of Vanclaw
(distance) (direction) (nearest town)

CODED

WELL PURPOSE: home
(home, irrigation, municipal, industrial)


- WELL COMPLETION DATA:
- (1) diameter (inches) 2
 - (2) total depth (feet) 253
 - (3) static water level (feet) _____ below above top of ground.
 - (4) casing galv. 253
(material) (depth)
(size) if telescope see back.
 - (5) screen 5' 253
(length) (depth to top)
2" strainer
(size) (material)
 - (6) pump 1 1/2 15
(HP) (yield gpm)
elec
(type power)
 - (7) electric log no
(yes or no)
(organization running log)
 - (8) how well bottom plugged BP Vanclaw

DRILLERS REMARKS:

DEC 21 1973

If well telescopes please sketch and show depths.

GROUND LEVEL

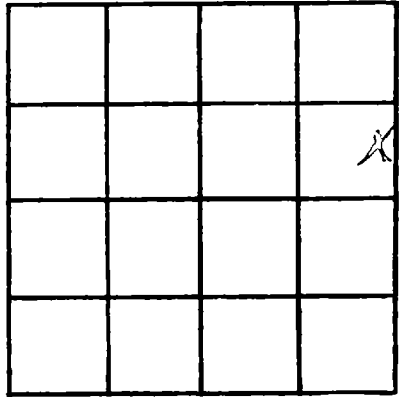

SECTION 14

Please indicate well location X.

ADDITIONAL INFORMATION

If more than one screen, show locations of each on sketch.