

JACKSON  
K127  
8-27-73

MISSISSIPPI  
BOARD OF WATER COMMISSIONERS CODED  
416 North State Street  
Jackson, Mississippi 39201

WATER WELL DRILLERS LOG

August 27 1973 H.A. Ladwice's Well Works Jackson  
date well completed firm name county well located

LANDOWNER:	description of formations encountered	from	to
NAPIER	yellow clay	0	50
Vanderve, Miss.	yellow sand	50	90
(mailing address)	blue clay	90	200
WELL LOCATION:	blue sand	200	235
sec. 5 T. 10 S. R. 7 W.			
DB miles NE of Vanderve			
(distance) (direction) (nearest town)			
WELL PURPOSE: HOME			
(home, irrigation, municipal, industrial)			
WELL COMPLETION DATA:			
(1) diameter (inches) 2 inch			
(2) total depth (feet) 235 ft.			
(3) static water level (feet) 85 below top of ground			
(4) casing 2 GALV. 225 ft.			
(material) (depth)			
2 inch (size) if telescope see back.			
(5) screen 10 ft. 225 ft.			
(length) (depth to top)			
2 inch, stainless steel (size) (material)			
(6) pump 2 (HP) 7 (yield gpm)			
Electric (type power)			
(7) electric log NO (yes or no)			
(organization running log)			
(8) how well bottom plugged Ball Check			
DRILLERS REMARKS:			


RECEIVED

NOV - 4 1974

OF WATER COMM

If well telescopes please sketch and show depths.

GROUND LEVEL

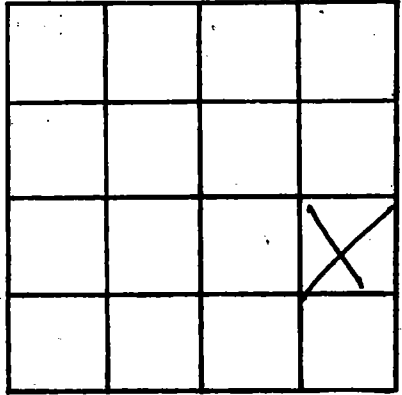

SECTION 5

Please indicate well location X.

ADDITIONAL INFORMATION

If more than one screen, show locations of each on sketch.