

Jackson
 K 129
 6-1-74

MISSISSIPPI
 BOARD OF WATER COMMISSIONERS
 416 North State Street
 Jackson, Mississippi 39201 **CODED**

WATER WELL DRILLERS LOG

6/1 19 74 COAST WATER WELL SERVICE *Jackson*
 date well completed firm name county well located

LANDOWNER: *L.G. Whitmore*
Rt. 4 Box H 150
Ocean Springs Miss
 (mailing address)

| description of formations encountered | from | to |
|---------------------------------------|------------|------------|
| <i>top soil</i> | <i>0</i> | <i>10</i> |
| <i>red clay</i> | <i>10</i> | <i>21</i> |
| <i>coarse sand</i> | <i>21</i> | <i>40</i> |
| <i>blue clay</i> | <i>40</i> | <i>101</i> |
| <i>fine sand</i> | <i>101</i> | <i>123</i> |
| <i>coarse sand</i> | <i>123</i> | <i>246</i> |
| <i>coiled clay</i> | <i>246</i> | <i>307</i> |
| <i>coarse sand</i> | <i>307</i> | <i>380</i> |

WELL LOCATION:
 sec. *20* T. *6* S. R. *7* W. (?)
2 1/2 miles *NE* of *Venatche*
 (distance) (direction) (nearest town)

WELL PURPOSE: *Home*
 (home, irrigation, municipal, industrial)


WELL COMPLETION DATA:
 (1) diameter (inches) *2"*
 (2) total depth (feet) *380'*
 (3) static water level (feet) *60* below above top of ground.
 (4) casing *PVC* *370'*
 (material) (depth)
2" if telescope see back.
 (size)
 (5) screen *10'* *380'*
 (length) (depth to top)
2" *PVC*
 (size) (material)
 (6) pump *1* *8 1/2*
 (HP) (yield gpm)
elec
 (type power)
 (7) electric log *NO*
 (yes or no)
 (organization running log)
 (8) how well bottom plugged *B.W. Value*

DRILLERS REMARKS: _____

RECEIVED
 JAN 13 1975

If well telescopes please sketch and show depths.

GROUND LEVEL

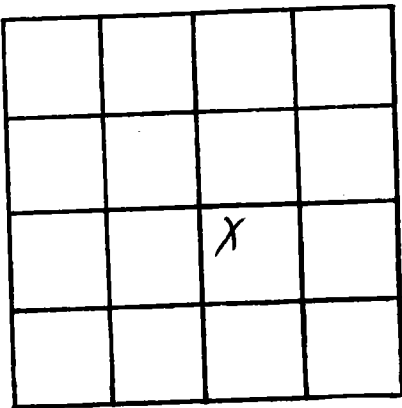

SECTION 20

Please indicate well location X.

ADDITIONAL INFORMATION

A series of horizontal lines for writing additional information, starting below the 'ADDITIONAL INFORMATION' header and extending down to the bottom of the page.

If more than one screen, show locations of each on sketch.