

K130

MISSISSIPPI BOARD OF WATER COMMISSIONERS
416 North State Street
Jackson, Mississippi 39201

CODED

~~211~~
Jackson
5/1/75

WATER WELL DRILLERS LOG

May 1 1975 Abille Water Supply Jackson
date well completed firm name county well located

LANDOWNER: Citizens National Bank
Waveland Miss.
(mailing address)

WELL LOCATION:
sec. 10 T. 11 N. R. 7 E
Waveland
(distance) (direction) (nearest town)

WELL PURPOSE: bank
(home, irrigation, municipal, industrial)

- WELL COMPLETION DATA:
- (1) diameter (inches) 4
 - (2) total depth (feet) 905
 - (3) static water level (feet) 20 ^{below} _{above} top of ground
 - (4) casing plst 890
(material) (depth)
(size) if telescope see back.
 - (5) screen 15 890
(length) (depth to top)
2 plst
(size) (material)
 - (6) pump iso pump
(HP) (yield gpm)
(type power)
 - (7) electric log no
(yes or no)
(organization running log)
 - (8) how well bottom plugged BP

description of formations encountered	depth	
	from	to
Clay	0	19
sand	19	132
Clay	132	264
sand	264	286
Clay	286	386
sand	386	416
Clay	416	462
at depth	462	550
sand	550	570
Clay	570	572
quartz clay	572	660
sand	660	704
quartz	704	770
Clay	770	802
quartz	802	836
sand	836	905

RECEIVED


JUN 5 1975

MISS. BD. OF WATER COMM

DRILLERS REMARKS:

If well telescopes please sketch and show depths.

GROUND LEVEL

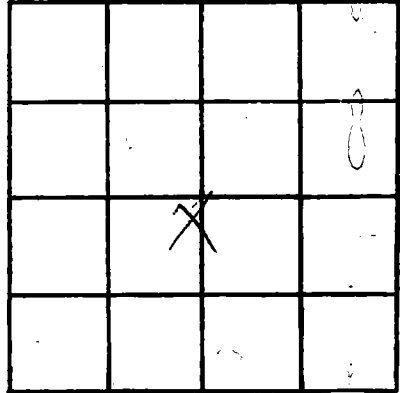

SECTION 16

Please indicate well location X.

ADDITIONAL INFORMATION:

If more than one screen, show locations of each on sketch.