

Jackson  
 R 138  
 10/14/74

MISSISSIPPI  
 BOARD OF WATER COMMISSIONERS  
 416 North State Street  
 130 Jackson, Mississippi 39201

WATER WELL DRILLERS LOG

10/14 1974 date well completed  
 COAST WATER WELL SERVICE firm name  
 Jackson county well located

LANDOWNER: Murray Holden  
 Rt. 4 Box 236  
 Ocean Springs, Ms  
 (mailing address)

description of formations encountered	from	to
top soil	0	15
coarse sand	15	45
gray clay	45	90
coarse sand	90	172
Blue clay	172	225
Med. sand	225	236
Blue clay	236	320
fine sand	320	340
Med + fine sand	340	372
coarse sand	372	387

WELL LOCATION:  
 sec. 11 T. 6 S. R. 7 W.  
 3 miles E Vonclaire  
 (distance) (direction) of (nearest town)

WELL PURPOSE: Home  
 (home, irrigation, municipal, industrial)

WELL COMPLETION DATA:  
 (1) diameter (inches) 2"  
 (2) total depth (feet) 387'  
 (3) static water level (feet) 68 below top of ground.  
 (4) casing PVC 372' (material) (depth)  
 2" (size) if telescope see back.  
 (5) screen 10' 372' (length) (depth to top)  
 2" PVC (size) (material)  
 (6) pump 1 (HP) 8 (yield gpm)  
 elec. (type power)  
 (7) electric log NO (yes or no)  
 (organization running log)  
 (8) how well bottom plugged B.W. Value


RECEIVED  
 MISSISSIPPI BOARD OF WATER COMMISSIONERS  
 OCT 22 1974

DRILLERS REMARKS:

MISS. BD. OF WATER COMMISSIONERS

If well telescopes please sketch and show depths.

GROUND LEVEL

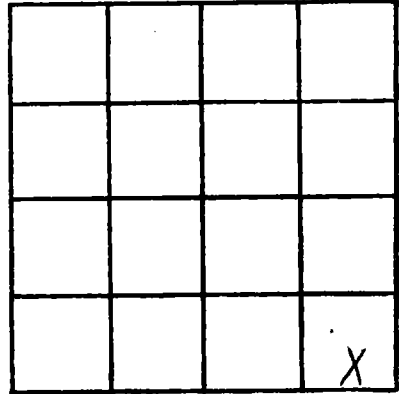

SECTION 11

Please indicate well location X.

ADDITIONAL INFORMATION

If more than one screen, show locations of each on sketch.