

MISSISSIPPI DEPARTMENT OF NATURAL RESOURCES

Bureau of Land and Water Resources

Southport Mall

P.O. Box 10631

Jackson, Mississippi 39209

WATER WELL DRILLERS LOG

CODED

JACKSON
K 141
3-21-81
3-21

date well completed

81 Coast Water Well Serv. Jackson

firm name

county well located

LANDOWNER:

T. L. Hughes
P.O. Box 177-H
Ocean Springs, Miss.
(mailing address) 39564

description of formations encountered

from

to

Top soil	0	3-
Red Clay	3"	25'
M. Sand	25'	35'
B. Clay	35'	60'
M. C. Sand	60'	137'
B. Clay	137'	190'
M. Sand	190'	210'

WELL LOCATION:

sec. 27 6^N R. 7^W
1 1/2 miles SE of VAN CLEAVE
(distance) (direction) (nearest town)

WELL PURPOSE:

(home, irrigation, municipal, industrial)

Home

WELL COMPLETION DATA:

- (1) diameter (inches) 2"
- (2) total depth (feet) 210'
- (3) static water level (feet) 20' below top of ground.
- (4) casing PVC, 200' (material) (depth)
- (size) 2" If telescope see back.
- (5) screen 10', 200' (length) (depth to top)
- (size) 2" (material) PVC
- (6) pump (HP) 13- (yield gpm)
- Elect. (type power)
- (7) electric log No. (yes or no)
- (organization running log)

(8) has well bottom plugged

Back Wash Valve

DRILLERS REMARKS:

DEPT. OF NATURAL RESOURCES
BUREAU OF LAND & WATER RESOURCES


APR - 9 1981

RECEIVED

If well telescopes please
sketch and show depths.

123710

GROUND LEVEL

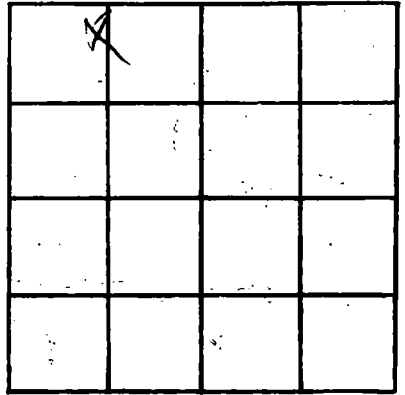

SECTION 27

Please indicate well location X.

ADDITIONAL INFORMATION

If more than one screen,
show locations of each on sketch.