

MISSISSIPPI
BOARD OF WATER COMMISSIONERS
416 North State Street
Jackson, Mississippi 39201

CODED

WATER WELL DRILLERS LOG

JACKSON
K 145
8-21-80

8-21-80 19 Cozart Water Well Service Jackson date well completed firm name county well located

LANDOWNER:	description of formations encountered	from	to
James C. Locke IV Rt. 4 Box 765 Ocean Spg. Mo. 39564 (Mail Bag address)	Top Soil	0	3
WELL LOCATION: Sec. 33 T. 6 S. R. 7 W. 4 miles S of VANC LEAVE (distance) (direction) (nearest town)	Red Clay	3	60
WELL PURPOSE: Home (home, irrigation, municipal, industrial)	Red Med. Sand	60	85
WELL COMPLETION DATA: (1) diameter (inches) 2" (2) total depth (feet) 394' (3) static water level (feet) 72' ^{below} _{above} top of ground. (4) casing PVC 384' (material) (depth) 2" (size) if telescope see back. (5) screen 10' 384' (length) (depth to top) 2" (size) PVC (material) (6) pump 1 1/2" HP -8- (HP) (yield gpm) elec (type power) (7) electric log NO (yes or no) (organization running log) (8) how well bottom plugged Backwash valve	Blue Clay	85	112
	Gray Coarse Sand	112	192
	Blue Clay	192	248
	Gray Coarse Sand		
	Blue Clay + Sand	248	258
	Blue fine Sand	258	280
	Blue Clay + Sand	280	357
	Gray Coarse Sand	357	394
DRILLERS REMARKS:			


DEPT. OF NATURAL RESOURCES
BUREAU OF LAND & WATER RESOURCES

APR -7 1981

RECEIVED

If well telescopes please sketch and show depths.

GROUND LEVEL

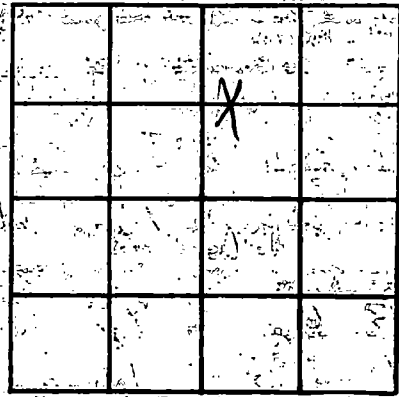

SECTION 33

Please indicate well location X.

ADDITIONAL INFORMATION

If more than one screen show locations of each on sketch.