

MISSISSIPPI DEPARTMENT OF NATURAL RESOURCES

Bureau of Land and Water Resources

Southport Mall

P.O. Box 10631

Jackson, Mississippi 39201

WATER WELL DRILLERS LOG

CODED

Jackson
K148
5-26-81

5-26-81
date well completed

81 Coast Water Well Service, Jackson
firm name

county well located

LANDOWNER: Mike Young
John & Layton Young
Vanclave, Miss.
(mailing address)

description of formations encountered

from

to

Top soil	0	3'
Red Clay	3'	18'
Red Coarse sand	18'	47'
Blue Clay	47'	60'
Red Coarse sand	60'	118'
Blue Clay	118'	468'
Gray Coarse sand + gravel	468'	510'
Blue Clay	510'	755'
Blue Clay & Chalk shell	755'	780'
Blue Clay	780'	1250'
Gray med. sand	1250'	1340'

WELL LOCATION:

sec. 25 T. 6 N. R. 7 E. S. 4
4 miles SE of VANCLAVE
(distance) (direction) (nearest town)


WELL PURPOSE: Home
(home, irrigation, municipal, industrial)

WELL COMPLETION DATA:

- (1) diameter (Inches) 2"
- (2) total depth (feet) 1340
- (3) static water level (feet) flow below top of ground.
- (4) casing PVC 1320' (material) (depth)
- (5) screen 2" 20' 1320' (size) (length) (depth to top)
- (6) pump = PVC flow (HP) (yield gpm)
- (type power)
- (7) electric log No. (yes or no)
- (organization running log)

(8) how well bottom plugged
Pack wash valve.

DRILLERS REMARKS:

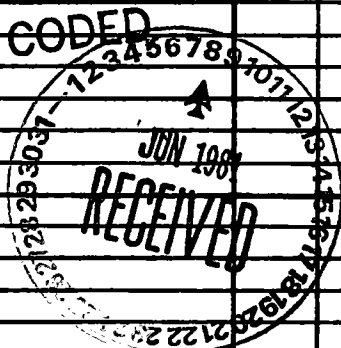

If well telescopes please sketch and show depths.

GROUND LEVEL

SECTION 25

Please indicate well location X.

ADDITIONAL INFORMATION



If more than one screen, show locations of each on sketch.