

MISSISSIPPI DEPARTMENT OF NATURAL RESOURCES

Bureau of Land and Water Resources

Southport Mall

P.O. Box 10631

CODED

Jackson, Mississippi 39209  
WATER WELL DRILLERS LOG

Jackson  
K149  
4-9-81

4-9-81 19 Coash Water Well Serv. Inc. Jackson  
date well completed firm name county well located

LANDOWNER: W.D. Buchanan  
2721 Pleasant St  
Pascagoula, Missi.  
(mailing address) 39567

| description of formations encountered | from | to   |
|---------------------------------------|------|------|
| Top soil                              | 0    | 1'   |
| White Clay                            | 1'   | 45'  |
| Blue Clay                             | 45'  | 217' |
| blue clay + streak of sand            | 217' | 225' |
| Gray fine sand                        | 225' | 240' |
| blue clay                             | 240' | 292' |
| Gray med. sand                        | 292' | 340' |

WELL LOCATION:  
sec. 13 T. 6 N. R. 7 E  
3 1/2 miles ESE of VANLEAVEN  
(distance) (direction) (nearest town)

WELL PURPOSE: Home  
(home, irrigation, municipal, industrial)

WELL COMPLETION DATA:  
(1) diameter (inches) 4" x 2"  
(2) total depth (feet) 340  
(3) static water level (feet) 66' below top of ground.  
(4) casing PVC (material), 320' (depth)  
4" x 2" (size) if telescope see back.  
(5) screen 20' (length), 320' (depth to top)  
4" x 2" (size), PVC (material)  
(6) pump 1 hp. Subm (HP), 28 (yield gpm)  
Elect. (type power)  
(7) electric log yes (yes or no)  
\_\_\_\_\_ (organization running log)

CODED

DEPT. OF NATURAL RESOURCES  
BUREAU OF LAND & WATER RESOURCES


JUN 2 - 1981

RECEIVED

(8) how well bottom plugged  
Back Wash Valve

DRILLERS REMARKS: \_\_\_\_\_

If well telescopes please sketch and show depths.

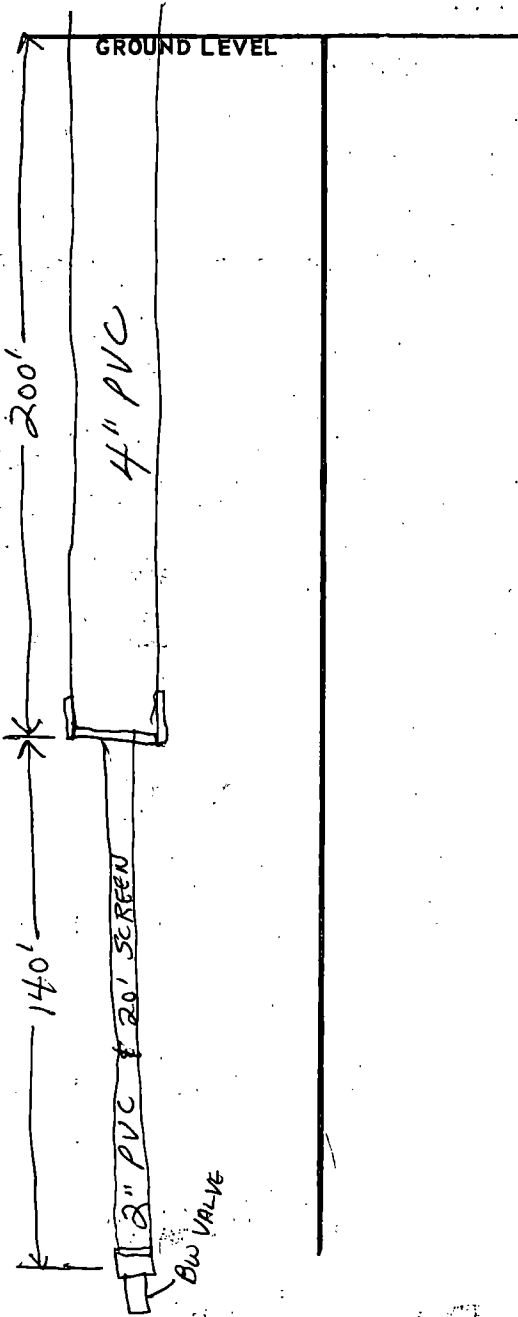

|  |  |  |   |
|--|--|--|---|
|  |  |  |   |
|  |  |  |   |
|  |  |  | X |
|  |  |  |   |

SECTION 13

Please indicate well location X.

ADDITIONAL INFORMATION

If more than one screen, show locations of each on sketch.