

Jackson
 K150
 4-15-82
 Elog # 240

MISSISSIPPI
 BOARD OF WATER COMMISSIONERS
 416 North State Street
 Jackson, Mississippi 39201

CODED

WATER WELL DRILLERS LOG

04-15-1982 LAYNE-CENTRAL COMPANY JACKSON
 date well completed firm name county well located

LANDOWNER:	description of formations encountered	from	to
Jackson County School District VANCLEAVE ATTENDANCE CENTER VANCLEAVE Mississippi (mailing address)	SAND & CLAY STREAKS CLAY & SAND STREAKS BLUE CLAY FINE SAND + CLAY SAND	0' 150' 469' 800' 870'	150' 469' 800' 870' 906'
WELL LOCATION: sec 16 T. 6 N. R. 7 E S W _____ miles _____ of _____ (distance) (direction) (nearest town)			
WELL PURPOSE: DOMESTIC (home, irrigation, municipal, industrial)			
WELL COMPLETION DATA:	CODED		
(1) diameter (inches) 6"			
(2) total depth (feet) 904'			
(3) static water level (feet) <u>Flowing</u> below top of ground.			
(4) casing <u>STEEL</u> <u>870'</u> (material) (depth) 6" If telescope see back. (size) 42' or 4"			
(5) screen <u>30'</u> <u>832'</u> (length) (depth to top)			
(6) pump <u>4"</u> <u>STAINLESS STEEL</u> (size) (material) <u>Submersible</u> (HP) <u>100 GPM</u> (yield gpm) <u>Electric</u> (type power)			
(7) electric log <u>Yes</u> (yes or no) <u>LAYNE-CENTRAL Co.</u> (organization running log)			
(8) how well bottom plugged <u>Solid Bottom</u> <u>w/ plate</u>			
DRILLERS REMARKS:			


CODED

DEPT. OF NATURAL RESOURCES
 BUREAU OF LAND & WATER RESOURCES

MAY 24 1982

RECEIVED

If well telescopes please sketch and show depths.

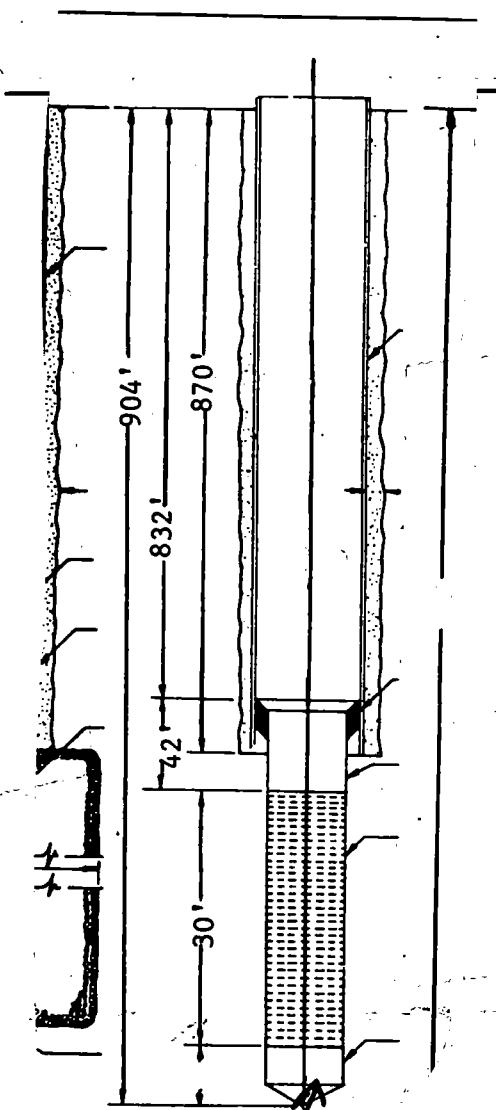

SOLID BOTTOM STARTED
TOTAL

SECTION _____

Please indicate well location X.

ADDITIONAL INFORMATION

If more than one screen, show locations of each on sketch.