

MISSISSIPPI DEPARTMENT OF NATURAL RESOURCES

Bureau of Land and Water Resources

Southport Mall

P.O. Box 10631

Jackson, Mississippi 39209

WATER WELL DRILLERS LOG

**CODED**

0015  
**JACKSON**  
**K152**  
**4-11-83**

947-3262

4-11 1983  
 date well completed

83 Inygoke water well JACKSON  
 firm name county well located

LANDOWNER: Renneth Cole  
1003 South 22<sup>nd</sup> St.  
Passagonla, Ms  
 (mailing address)

description of formations encountered	from	to
top sand	0	10
sand	10	20
sand	20	28
clay	28	40
sand clay	40	60
silt sand	60	80
clay	80	100
med sand	105	125

**CODED**

WELL LOCATION:  
 sec 25 T 6 N R 2 E  
5 miles East of Amelia  
 (distance) (direction) (nearest town)

WELL PURPOSE: home  
 (home, irrigation, municipal, industrial)

WELL COMPLETION DATA:

- (1) diameter (inches) 4"
- (2) total depth (feet) 135'
- (3) static water level (feet) 50 <sup>below</sup> above top of ground.
- (4) casing PVC 125'  
 (material) (depth)  
no If telescope see back.  
 (size)
- (5) screen 10' 125'  
 (length) (depth to top)  
4" PVC  
 (size) (material)
- (6) pump 1/3 20  
 (HP) (yield gpm)  
Electric  
 (type power)
- (7) electric log yes of no  
Bureau Prod  
 (organization running log)
- (8) how well bottom plugged PVC  
Ball Check


E log show  
see 25 65 NW  
E log show a depth of  
1010'  
No water  
 DEPT. OF NATURAL RESOURCES  
 BUREAU OF LAND AND WATER RESOURCES  
 JUN 13 1983

DRILLERS REMARKS:  
good well  
Chemical analysis good

**RECEIVED**

If well telescopes please sketch and show depths.

GROUND LEVEL

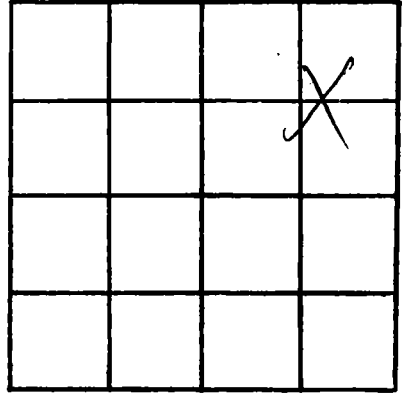

SECTION 24

Please indicate well location X.

ADDITIONAL INFORMATION

If more than one screen,  
show locations of each on sketch.