

MISSISSIPPI DEPARTMENT OF NATURAL RESOURCES

Bureau of Land and Water Resources

Southport Mall

P.O. Box 10631

Jackson, Mississippi 39209

CODED

WATER WELL DRILLERS LOG

JACKSON
K153
1-7-84

1-7-84 date well completed 19 Coast Water Well Sew. firm name Jackson county well located

LANDOWNER: Arthur Heath
PO Box # 21
Gautier, Miss.
 (mailing address) 39533

description of formations encountered	from	to
Top soil	0	6'
Red Clay	6'	19'
Red Coarse sand		
Wood & gravel	19'	100'
Blue Clay	100'	170'
Gray Coarse sand	170'	194'
Blue Clay	194'	260'
Gray fine sand	260'	319'
Blue Clay	319'	605'
Blue Clay & clamshell	605'	820'
gray fine sand	820'	838'
gray med. sand	838'	848'
gray Coarse sand	848'	875'
gray med. sand & wood	875'	885'
Tail Pipe 10"x2"		

WELL LOCATION:
 sec. 16 T. 6 S. R. 7 E.
1N miles (distance) (direction) of VAN CLEAVE (nearest town)

WELL PURPOSE: Neatoh Clinic
 (home, irrigation, municipal, industrial)

- WELL COMPLETION DATA:
- (1) diameter (inches) 2"
 - (2) total depth (feet) 885'
 - (3) static water level (feet) flow below above top of ground.
 - (4) casing PVC 865'
 (material) (depth)
 - 2" (size) if telescope see back.
 - (5) screen 20' 865'
 (length) (depth to top)
 - 2" (size) PVC (material)
 - (6) pump 1/2 hp. flow-regul.
 (HP) (yield gpm)
 - elect (type power)
 - (7) electric log No.
 (yes or no)
 - (organization running log)
 - (8) how well bottom plugged back wash valve

DEPT. OF NATURAL RESOURCES
 BUREAU OF LAND & WATER RESOURCES


MAR - 1 1984

RECEIVED

DRILLERS REMARKS:

If well telescopes please sketch and show depths.

GROUND LEVEL

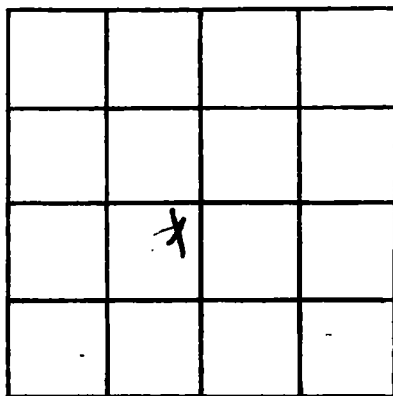

SECTION _____

Please indicate well location X.

ADDITIONAL INFORMATION

If more than one screen, show locations of each on sketch.