

MISSISSIPPI DEPARTMENT OF NATURAL RESOURCES

Bureau of Land and Water Resources

Southport Mall

P.O. Box 10631

Jackson, Mississippi 39209

CODED

WATER WELL DRILLERS LOG

JACKSON
15154
4-18-84

4-18

19

84 Coast water well serv.

Jackson

date well completed

firm name

county well located

LANDOWNER: U.S. Post Office

description of formations encountered

from

to

King Construction Co.

Top Soil

0' 6'

Vanceleave, Ms.

Red Clay

CODED

6' 19'

(mailing address)

WELL LOCATION:

Red Clay & streak of sand

19' 27'

sec. 16 T. 6 N. R. 7 E. S. W.

Red Clay

27' 80'

1N miles of Vanceleave (distance) (direction) (nearest town)

WELL PURPOSE: (home, irrigation, municipal, industrial)

Red Coarse Sand & gravel

80' 108'

WELL COMPLETION DATA:

Blue Clay

108' 172'

(1) diameter (inches) 5"

Gray Coarse Sand

172' 186'

(2) total depth (feet) 186'

(3) static water level (feet) 38' below top of ground

(4) casing Steel, 165' (material) (depth)

5" (size) if telescope see back.

(5) screen 15' length, 171' depth to top

2" stainless steel (size) (material)

(6) pump 1 1/2 HP, 25 yield gpm

elec. (type power)

(7) electric log No (yes or no)

(organization running log)

(8) how well bottom plugged Backwash valve

DRILLERS REMARKS:


DEPT. OF NATURAL RESOURCES BUREAU OF LAND & WATER RESOURCES

JUL 10 1984

RECEIVED

If well telescopes please sketch and show depths.

GROUND LEVEL

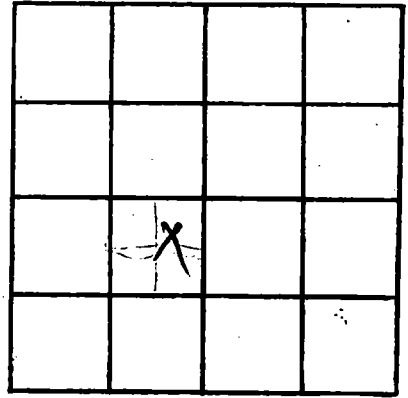

SECTION 16

Please indicate well location X.

ADDITIONAL INFORMATION

If more than one screen, show locations of each on sketch.