

**MISSISSIPPI DEPARTMENT OF NATURAL RESOURCES**  
**Bureau of Land and Water Resources**  
 Southport Mall  
 P.O. Box 10631  
 Jackson, Mississippi 39209  
**WATER WELL DRILLERS LOG**

**CODED**

JACKSON  
 K 155

7-24 date well completed      84 Coast Water Well Sew. firm name      Jackson county well located

LANDOWNER: Larry J. Meyers  
Rt 6-9113 Hwy 57  
Ocean Springs, Miss.  
 (mailing address) 39564

WELL LOCATION:  
 sec 32 T 6 N R 7 E  
5 miles S of Vanklave  
 (distance) (direction) (nearest town)

WELL PURPOSE: Home  
 (home, irrigation, municipal, industrial)


WELL COMPLETION DATA:  
 (1) diameter (inches) 4 X 2"  
 (2) total depth (feet) 774'  
 (3) static water level (feet) 21' below top of ground.  
 (4) casing PVC, 744'  
 " (material) (depth)  
4 X 2" if telescope see back.  
 (size)  
 (5) screen 30', 744'  
 (length) (depth to top)  
4 X 2", PVC  
 (size) (material)  
 (6) pump 1 1/2" Subj. Pump, 18  
 (HP) (yield gpm)  
Electric  
 (type power)  
 (7) electric log No  
 (yes or no)  
 (organization running log)  
 (8) How well bottom plugged:  
Backwash valve

description of formations encountered	from	to
Top soil	0	2'
Red Clay	2'	19'
Blue Clay	19'	51'
Blue Clay & streaky sand	51'	75'
Red Coarse sand	75'	83'
Blue Clay	83'	101'
Red Coarse sand	101'	180'
Blue Clay	180'	291'
Blue Clay & streaky sand	291'	298'
Blue Clay	298'	334'
Gray Coarse sand	334'	390'
Blue Clay <b>CODED</b>	390'	405'
Blue Clay & streaky sand	405'	430'
Blue Clay	430'	602'
Blue Clay & streaky sand	602'	620'
Blue Clay	620'	710'
Gray Coarse sand	710'	765'
Blue Clay & streaky sand	765'	774'
10" 2" Tail Pipe.		

DRILLERS REMARKS: \_\_\_\_\_

If well telescopes please sketch and show depths.

GROUND LEVEL

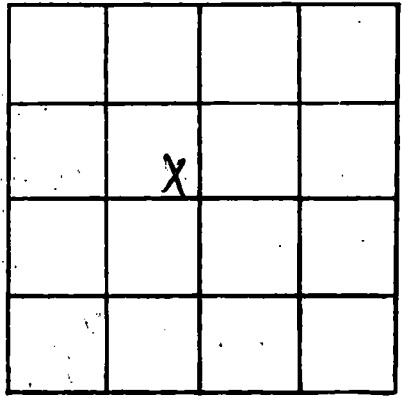

SECTION 32

Please indicate well location X.

ADDITIONAL INFORMATION

Multiple horizontal lines for additional information.

If more than one screen, show locations of each on sketch.

BEST COPY AVAILABLE  
BUREAU OF LAND & WATER RESOURCES  
OCT 11 1964  
RECEIVED