

JACKSON
K156

MISSISSIPPI DEPARTMENT OF NATURAL RESOURCES
Bureau of Land and Water Resources
Southport Mall
P.O. Box 10631
Jackson, Mississippi 39209
WATER WELL DRILLERS LOG

CODED


6/25/84 Fryfogle Water Well Jackson
date well completed film name county well located

LANDOWNER: <u>MARVIN TALLEY</u> <u>P.O. Box 1211</u> <u>LAUREL, MS</u> (mailing address)	description of formations encountered	from	to
	<u>Topsoil & SAND</u>	<u>0</u>	<u>45</u>
	<u>CLAY</u>	<u>45</u>	<u>55</u>
	<u>SAND</u>	<u>55</u>	<u>75</u>
	<u>CLAY</u>	<u>75</u>	<u>80</u>
	<u>SAND</u>	<u>80</u>	<u>115</u>
CODED			
WELL LOCATION: sec <u>25</u> T <u>8</u> N R <u>7</u> E <u>10</u> miles <u>SE</u> of <u>VANCELEAVE</u> (distance) (direction) (nearest town)			
WELL PURPOSE: <u>CAMP</u> (home, irrigation, municipal, industrial)			
WELL COMPLETION DATA: (1) diameter (inches) <u>4"</u> (2) total depth (feet) <u>115'</u> (3) static water level (feet) <u>30</u> ^{below} above top of ground. (4) casing <u>PVC</u> , <u>115'</u> (material) (depth) <u>4"</u> (size) if telescope see back. (5) screen <u>10'</u> (length) (depth to top) <u>#6</u> , <u>PVC</u> (size) (material) (6) pump <u>1/2</u> <u>25</u> (HP) (yield gpm) <u>Elec</u> (type power) (7) electric log <u>NO</u> (yes or no) <u></u> (organization running log) (8) how well bottom plugged <u>good</u>			
DRILLERS REMARKS:			

MISSISSIPPI DEPARTMENT OF NATURAL RESOURCES
BUREAU OF LAND & WATER RESOURCES
RECEIVED
OCT 29 1984

If well telescopes please sketch and show depths.

GROUND LEVEL

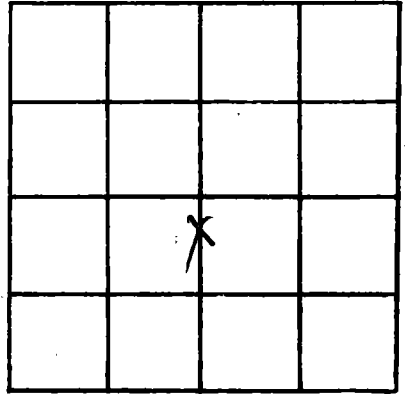

SECTION 2.5

Please indicate well location X.

ADDITIONAL INFORMATION

If more than one screen, show locations of each on sketch.