

MISSISSIPPI DEPARTMENT OF NATURAL RESOURCES

Bureau of Land and Water Resources

Southport Mall

P.O. Box 10631

CODED

Jackson, Mississippi 39209

WATER WELL DRILLERS LOG

K157
JACKSON
1-18-85

1-18-85 date well completed
Coast Water Well Sew. firm name
Jackson county well located

LANDOWNER: James Guthrie
P.O. Box 5034
Vandeventer, Miss 39566 Branch (mailing address)

WELL LOCATION:
sec. 13 T. 6 N. R. 7 E. S. 7 W.
3 miles East of Vandeventer (distance) (direction) (nearest town)

WELL PURPOSE: Home (home, irrigation, municipal, industrial)

WELL COMPLETION DATA:
(1) diameter (inches) 2"
(2) total depth (feet) 210'
(3) static water level (feet) 45' below top of ground.
(4) casing PVC, 200' (material) (depth)
2" (size) if telescope see back.
(5) screen 10' length, 200' depth to top
2" (size) PVC (material)
(6) pump H.P. 9 (HP) (yield gpm)
Elect. (type power)
(7) electric log No (yes or no)
(organization running log)
(8) how well bottom plugged: Backwash Valve


description of formations encountered	from	to
Top soil	0	3'
Gray Clay	3	58'
White sand	58'	140'
Blue Clay & Strip sand	140'	180'
Gray sand	180'	210'
5 ft 3" Tail Pipe		

RECEIVED
APR 2 - 1985

DRILLERS REMARKS:

If well telescopes please
sketch and show depths.

GROUND LEVEL

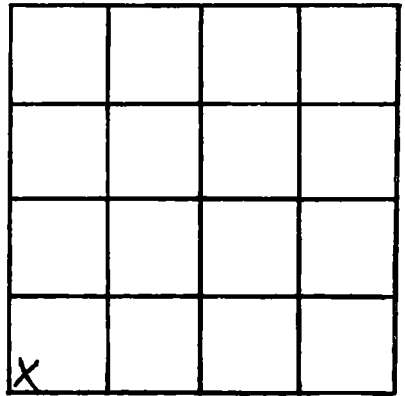

SECTION 13

Please indicate well location X.

ADDITIONAL INFORMATION

If more than one screen,
show locations of each on sketch.