

# MISSISSIPPI DEPARTMENT OF NATURAL RESOURCES

Bureau of Land and Water Resources

P.O. Box 10631  
Jackson, Mississippi 39209  
**WATER WELL DRILLERS LOG**

COUNTY WELL LOCATED <b>Jackson</b>	
WELL NUMBER <b>K159</b>	ICODED
DATE WELL COMPLETED <b>3-10-87</b>	

PERMIT NUMBER
NAME OF DRILLING FIRM <b>Coast Water Well Service, Inc</b>

CODED

NAME & MAILING ADDRESS OF LANDOWNER <b>Russell Griffin Hwy 57 Vandœuvre ms</b>			
WELL LOCATION: SEC	TOWNSHIP	RANGE	
<b>16</b>	<b>6</b>	<b>2</b>	<b>W</b>
DISTANCE	DIRECTION	NEAREST TOWN	
<b>0</b> Miles	<b>—</b>	<b>Vandœuvre</b>	
OTHER LANDMARK			
WELL PURPOSE: Home, Irrigation, Municipal, Industrial, Fish Pond, etc. <b>office + store building</b>			

PUMP DATA		
PUMP TYPE (Circle One): Submersible, Turbine, Jet, Flowing Well, Other (Describe) _____		
POWER TYPE (Circle One): Electric, Tractor, Diesel, Gasoline, Butane, Other (Describe) _____		
Pump Capacity (GPM)	No. of Stages	Setting Depth  <b>FT.</b>
PUMP TEST		
Well yielded _____ GPM with a drawdown of _____ ft. after _____ hours of pumping		

WELL DATA		
Well Depth <b>892</b>	Casing Diameter (In.) <b>2"</b>	Casing Length (Ft.) <b>867</b>
Type of Casing <b>PVC</b>	Hole Depth <b>892</b>	Depth to Static Water Level <b>Flow</b>
TYPE OF COMPLETION: (Circle One or More): Gravel Packed, Underreamed, Telescoped, Natural Development, Open Hole, Other		
Top of Lap Pipe or Reduction in Casing <b>FEET</b> IF TELESCOPED OR MORE THAN ONE SCREEN: USE BACK PAGE		

LOG DATA	
TYPE OF LOG RUN (Circle One): Electric, Gamma Ray, Density, Sonic, Neutron, Other (Describe) _____	
Name of Organization Running Log	

SCREEN DATA		
Diameter - Inches <b>2"</b>	Length - Feet <b>20'</b>	Slot Size - Inches <b>.008</b>
Screen Type <b>PVC</b>	Depth to Bottom - Feet <b>887</b>	

GEOLOGIC DATA (Office Use Only)			
Surface Elev.	Geologic Unit	Unit Thickness	Depth to Top
Subs. SWL	Date	Analysis	Aquifer Test


Driller's Remarks
-------------------

DESCRIPTION OF FORMATIONS ENCOUNTERED	FROM	TO
Top Soil	0	2
White Coarse sand	2	10
Brown Clay	10	30
White Coarse Sand	30	125
Blue Clay	125	260
Fine Gray Sand	260	280
Blue Clay	280	585
Fine Gray Sand	585	605
Blue Clay	605	860
Med Gray Sand	860	872
Coarse Gray Sand	872	887

FORMATION CONTINUED FROM <b>887</b> TO <b>892</b> <b>MAY 21 1987</b>
Department of Natural Resources Bureau of Land & Water Resources
IF MORE SPACE IS NEEDED, USE BACK

If well telescopes please sketch and show depths.

GROUND LEVEL

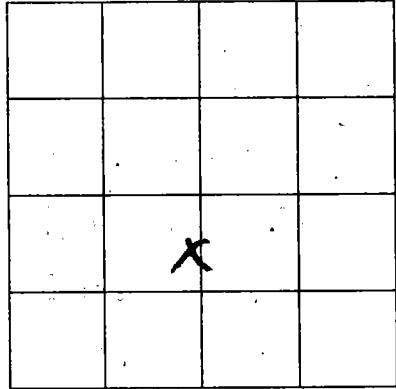

SECTION 16

Please indicate well location X.

ADDITIONAL INFORMATION

If more than one screen,  
show location of each on sketch.