

MISSISSIPPI DEPARTMENT OF ENVIRONMENTAL QUALITY

Office of Land and Water Resources

P. O. Box 10631
Jackson, MS 39289-0631
WATER WELL DRILLERS LOG

COUNTY WELL LOCATED <i>Jackson</i>	
WELL NUMBER <i>R 175</i>	CODED <input checked="" type="checkbox"/>
DATE WELL COMPLETED <i>3-4-94</i>	

PERMIT NUMBER
NAME OF DRILLING FIRM <i>Coast Water Well Serv. Inc.</i>

NAME & MAILING ADDRESS OF LANDOWNER <i>Donald Burkart #2 front</i>			
<i>Jimi Ramsey Rd</i>			
<i>Vanceleone, Ms</i>			
WELL LOCATION	SEC	TOWNSHIP	RANGE
	<i>7</i>	<i>6</i>	<i>N 7 W</i>
DISTANCE	DIRECTION	NEAREST TOWN	
<i>2</i> Miles	<i>W</i>	of <i>VANCELEONE</i>	
OTHER LANDMARK			
WELL PURPOSE: <input checked="" type="checkbox"/> Home, <input type="checkbox"/> Irrigation, <input type="checkbox"/> Municipal, <input type="checkbox"/> Industrial, <input type="checkbox"/> Fish Pond, etc.			

PUMP DATA		
PUMP TYPE (Circle One): Submersible, Turbine, <input checked="" type="radio"/> Jet, Flowing Well, Other (Describe) _____		
POWER TYPE (Circle One): <input checked="" type="radio"/> Electric, <input type="radio"/> Tractor, Diesel, Gasoline, Butane, Other (Describe) _____ H/P <i>2</i>		
Pump Capacity (GPM) <i>11</i>	No. of Stages <i>3</i>	Setting Depth _____ FT.
PUMP TEST		
Well yielded _____ GPM with a drawdown of _____ ft. after _____ hours of pumping		

WELL DATA		
Well Depth <i>347'</i>	Casing Diameter (In.) <i>2"</i>	Casing Length (Ft.) <i>334'</i>
Type of Casing <i>PVC</i>	Hole Depth <i>347'</i>	Depth to Static Water Level <i>80'</i>
TYPE OF COMPLETION: (Circle One or More): <input checked="" type="checkbox"/> Gravel Packed, <input type="checkbox"/> Underreamed, <input type="checkbox"/> Telescoped, <input checked="" type="checkbox"/> Natural Development, <input type="checkbox"/> Open Hole, <input type="checkbox"/> Other (Describe) _____		
WELL GROUTED TO A DEPTH OF <i>20</i> FEET Type Grout (circle one): Cement, <input checked="" type="checkbox"/> Bentonite, or Mix		

LOG DATA	
TYPE OF LOG RUN (Circle One): <input checked="" type="checkbox"/> No Log Run, <input type="checkbox"/> Electric, <input type="checkbox"/> Gamma Ray, <input type="checkbox"/> Density, <input type="checkbox"/> Sonic, <input type="checkbox"/> Neutron, Other (Describe) _____	
Name of Organization Running Log	

SCREEN DATA		
Diameter - Inches <i>2"</i>	Length - Feet <i>10'</i>	Slot Size - Inches <i>008</i>
Screen Type <i>PVC</i>	Depth to Bottom - Feet <i>344</i>	

GEOLOGIC DATA (Office Use Only)			
Surface Elev.	Geologic Unit	Unit Thickness	Depth to Top
Subs. SWL	Date	Analysis	Aquifer Test

Driller's Remarks	
Top of Lap Pipe or Reduction in Casing	
FEET	IF TELESCOPED OR MORE THAN ONE SCREEN, USE BACK PAGE

DESCRIPTION OF FORMATIONS ENCOUNTERED	FROM	TO
<i>Top soil</i>	<i>0</i>	<i>2</i>
<i>Gray Clay</i>	<i>2</i>	<i>18</i>
<i>Med. sand</i>	<i>18</i>	<i>35</i>
<i>Red + Blue Clay</i>	<i>35</i>	<i>90</i>
<i>Coarse sand + gravel</i>	<i>90</i>	<i>155</i>
<i>Blue Gray Sand</i>	<i>155</i>	<i>320</i>
<i>Med. Sand</i>	<i>320</i>	<i>344</i>
<i>Blue Clay</i>	<i>344</i>	<i>347</i>

RECEIVED


APR 07 1994

Dept. of Environmental Quality
Office of Land & Water Resources

IF MORE SPACE IS NEEDED, USE BACK

If well telescopes please sketch and show depths.

GROUND LEVEL

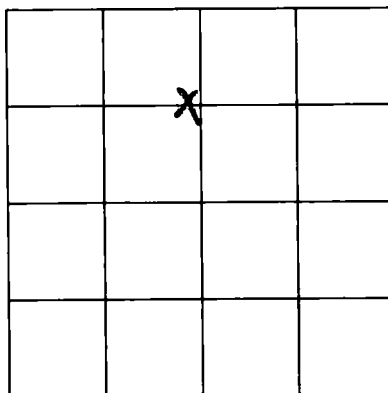

SECTION 7

Please indicate well location X.

ADDITIONAL INFORMATION

If more than one screen,
show location of each on sketch.