

COUNTY WELL LOCATED
Jackson
 WELL NUMBER *R308* CODED
 DATE WELL COMPLETED
5-27-97

✓
20

PERMIT NUMBER _____
 NAME OF DRILLING FIRM
Coast Water Well Service

MISSISSIPPI DEPARTMENT OF ENVIRONMENTAL QUALITY

Office of Land and Water Resources

P. O. Box 10631
 Jackson, MS 39289-0631
WATER WELL DRILLERS LOG

NAME & MAILING ADDRESS OF LANDOWNER
Deanna Bickham
Johna Bayou Rd.
Vanclave, Ms

WELL LOCATION SEC *4* TOWNSHIP *6^N 7^E* RANGE *(NW)*

DISTANCE *3* Miles DIRECTION *SE* of NEAREST TOWN *Vanclave*

OTHER LANDMARK _____

WELL PURPOSE Home, Irrigation, Municipal, Industrial, Fish Pond, etc.

PUMP DATA

PUMP TYPE (Circle One):
 Submersible, Turbine, Jet, Flowing Well,
 Other (Describe) _____

POWER TYPE (Circle One):
 Electric, Tractor, Diesel, Gasoline, Butane,
 Other (Describe) _____ H/P *1*

Pump Capacity (GPM) *8* No. of Stages *2* Setting Depth _____ FT.

PUMP TEST

Well yielded _____ GPM with
 a drawdown of _____ ft.
 after _____ hours of pumping

WELL DATA

Well Depth <i>355'</i>	Casing Diameter (in) <i>2"</i>	Casing Length (Ft) <i>345'</i>
Type of Casing <i>PVC</i>	Hole Depth <i>355'</i>	Depth to Static Water Level <i>60'</i>

TYPE OF COMPLETION: (Circle One or More):
 Gravel Packed, Underreamed, Telescoped,
 Natural Development, Open Hole, Other
 (Describe) _____

LOG DATA

TYPE OF LOG RUN (Circle One):
 Electric, Gamma Ray, Density, Sonic, No Log Run, Neutron,
 Other (Describe) _____

Name of Organization Running Log _____

WELL GROUTED TO A DEPTH OF *20* FEET
 Type Grout (circle one): Cement, Bentonite, or Mix

GEOLOGIC DATA (Office Use Only)

Surface Elev.	Geologic Unit	Unit Thickness	Depth to Top
Subs. SWL	Date	Analysis	Aquifer Test


SCREEN DATA

Diameter - Inches <i>2"</i>	Length - Feet <i>10'</i>	Slot Size - Inches <i>.004</i>
Screen Type <i>PVC wrapped</i>	Depth to Bottom - Feet <i>355'</i>	

Driller's Remarks _____

Top of Lap Pipe or Reduction in Casing _____ FEET


IF TELESCOPED OR MORE THAN ONE SCREEN: USE BACK PAGE

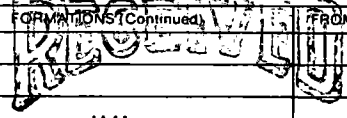DESCRIPTION OF FORMATIONS ENCOUNTERED	FROM	TO	FORMATIONS (Continued)	FROM	TO
<i>Top Soil</i>	<i>0</i>	<i>2</i>	 JUL 21 1997 Dept. of Environmental Quality Office of Land & Water Resources		
<i>Red clay</i>	<i>2</i>	<i>20</i>			
<i>White Coars sand</i>	<i>20</i>	<i>50</i>			
<i>Blue clay theef sand</i>	<i>50</i>	<i>100</i>			
<i>Med gray sand</i>	<i>100</i>	<i>130</i>			
<i>Blue clay theef sand</i>	<i>130</i>	<i>330</i>			
<i>Med gray sand</i>	<i>330</i>	<i>355</i>			

IF MORE SPACE IS NEEDED, USE BACK

If well telescopes please
sketch and show depths.

GROUND LEVEL

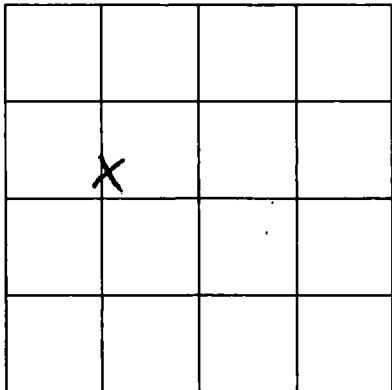

SECTION 4

Please indicate well location X.

ADDITIONAL INFORMATION

A series of approximately 20 horizontal lines for entering additional information.

If more than one screen,
show location of each on sketch.