



If well telescopes please sketch and show depths.


GROUND LEVEL

		X	

SECTION 7

Please indicate well location X.

ADDITIONAL INFORMATION

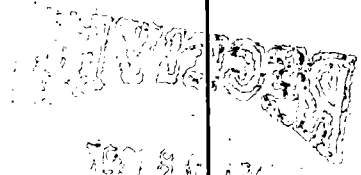

*Faint handwritten notes, possibly describing well details or measurements.*

If more than one screen, show location of each on sketch.