

MISSISSIPPI DEPARTMENT OF ENVIRONMENTAL QUALITY

Office of Land and Water Resources

P. O. Box 10631

Jackson, MS 39289-0631

WATER WELL DRILLERS LOG

COUNTY WELL LOCATED  
**JACKSON**

WELL NUMBER  
**K-327** CODED

DATE WELL COMPLETED  
**9-27-01**

PERMIT NUMBER  
**MS-GW-15703**

NAME OF DRILLING FIRM  
**TEST**

NAME & MAILING ADDRESS OF LANDOWNER  
**TEST**

**P.O. BOX 1770 Oceansprings MS 39566-1770**

Latitude:  
Longitude:

WELL LOCATION. SEC TOWNSHIP RANGE  
**26 6 N 7 E**

DISTANCE DIRECTION NEAREST TOWN  
Miles of

OTHER LANDMARK  
**"Rouse"**

WELL PURPOSE: Home, Irrigation, Municipal, Industrial, Fish Pond, etc.  
**Private**

PUMP DATA

PUMP TYPE (Circle One):  
 Submersible Turbine, Jet, Flowing Well,  
Other (Describe)

POWER TYPE (Circle One):  
 Electric, Tractor, Diesel, Gasoline, Butane,  
Other (Describe) **H/P 20**

DESCRIPTION OF FORMATIONS ENCOUNTERED	FROM	TO
clay	0	18
sand	18	60
clay	60	75
sand	75	85
clay	85	100
sand	100	158

REC'D DEC 03 2001

Top of Lap Pipe or Reduction in Casing  
**ground level** FEET

IF TELESCOPED OR MORE THAN ONE SCREEN: USE BACK PAGE

WELL DATA

Well Depth <b>158</b>	Casing Diameter (In.) <b>12"</b>	Casing Length (Ft.) <b>100FT</b>
Type of Casing <b>Black Iron</b>	Hole Depth <b>158</b>	Depth to Static Water Level <b>18FT</b>

TYPE OF COMPLETION: (Circle One or More):  
 Gravel Packed, Underreamed, Telescoped,  
Natural Development, Open Hole, Other  
(Describe)

WELL GROUTED TO A DEPTH OF **100** FEET  
Type Grout (circle one): Cement, Bentonite, or Mix

SCREEN DATA

Diameter - Inches <b>8</b>	Length - Feet <b>50</b>	Slot Size - Inches <b>20,000</b>
Screen Type <b>WOP</b>	Depth to Bottom - Feet <b>158</b>	


I certify that the well was drilled, constructed and completed in accordance with all applicable Requirements of the Mississippi Department of Environmental Quality and/or the Mississippi Department of Health regulations and state laws.

*James R. Brenn*  
Signature of Licensed Driller and License No.  
**# 0-653**

**11-21-01**  
Date

Additional Information Required On Back

If well telescopes please sketch and show depths.

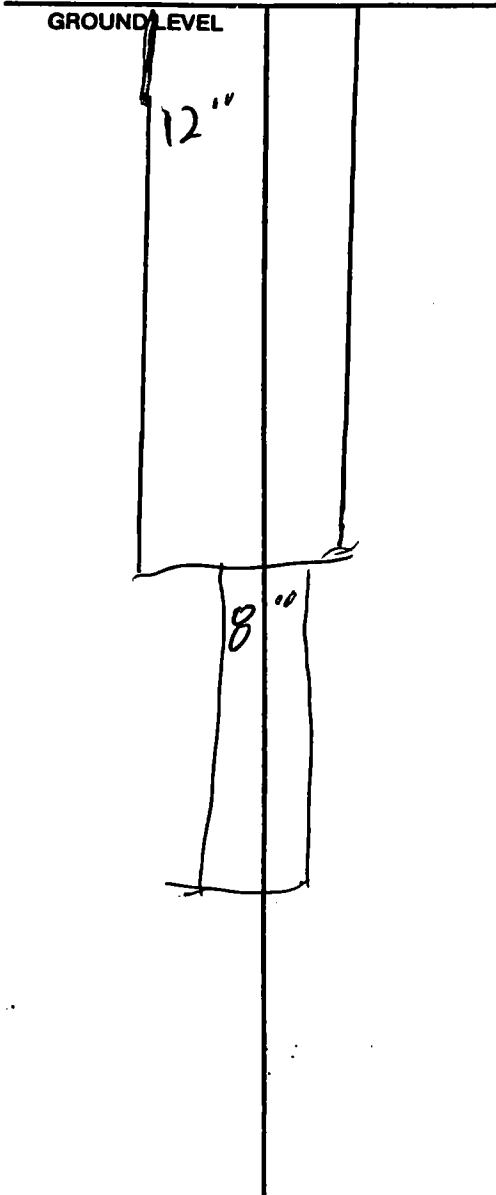

If more than one screen, show location of each on sketch.


SECTION \_\_\_\_\_

Please indicate well location X.

Pump Capacity (GPM) 190 under 50psi	No. of Stages 4	Setting Depth 120 FT.
---	--------------------	--------------------------

PUMP TEST

Well yielded 200 GPM with  
a drawdown of 22 ft.  
after 24 hours of pumping

LOG DATA

TYPE OF LOG RUN (Circle One): No Log Run,  
Electric, Gamma Ray, Density, Sonic, Neutron,  
Other (Describe) \_\_\_\_\_

Name of Organization Running Log

STATE Dept of Environmental

GEOLOGIC DATA (Office Use Only)

Surface Elev.	Geologic Unit	Unit Thickness	Depth to Top
Subs. SWL	Date	Analysis	Aquifer Test

Driller's Remarks

---



---



