

**MISSISSIPPI DEPARTMENT OF ENVIRONMENTAL
QUALITY**

Office of Land and Water Resources

P. O. Box 10631
Jackson, MS 39289-0631
WATER WELL DRILLERS LOG

COUNTY WELL LOCATED <u>Clackson</u>	
WELL NUMBER <u>R-3601</u>	CODED
DATE WELL COMPLETED <u>4-9-03</u>	

PERMIT NUMBER
NAME OF DRILLING FIRM <u>East Water Well Service</u>

NAME & MAILING ADDRESS OF LANDOWNER <u>Harold Clark</u>			
<u>Goin' Country</u>			
Latitude:			
Longitude: <u>Vandaveau Ms</u>			
WELL LOCATION	SEC	TOWNSHIP	RANGE
	<u>8</u>	<u>6</u>	<u>7</u>
DISTANCE <u>1 1/2</u> Miles	DIRECTION <u>West</u>	NEAREST TOWN <u>Vandaveau</u>	
OTHER LANDMARK			
WELL PURPOSE: <input checked="" type="radio"/> Home Irrigation, Municipal, Industrial, Fish Pond, etc.			

PUMP DATA	
PUMP TYPE (Circle One): Submersible, Turbine, <u>Jet</u> Flowing Well, Other (Describe)	
POWER TYPE (Circle One): <u>Electric</u> , Tractor, Diesel, Gasoline, Butane, Other (Describe) H/P <u>2</u>	

DESCRIPTION OF FORMATIONS ENCOUNTERED	FROM	TO
<u>Top Soil</u>	<u>0</u>	<u>2</u>
<u>Orange Clay</u>	<u>2</u>	<u>13</u>
<u>White Coarse Sand</u>	<u>13</u>	<u>40</u>
<u>White + Orange Clay</u>	<u>40</u>	<u>98</u>
<u>Brown Coarse Sand</u>	<u>98</u>	<u>160</u>
<u>Blue Clay</u>	<u>160</u>	<u>290</u>
<u>Gray Coarse Sand</u>	<u>290</u>	<u>318</u>

WELL DATA		
Well Depth <u>318'</u>	Casing Diameter (In.) <u>2"</u>	Casing Length (Ft.) <u>308'</u>
Type of Casing <u>PVC</u>	Hole Depth <u>318'</u>	Depth to Static Water Level <u>95'</u>
TYPE OF COMPLETION: (Circle One or More): <input checked="" type="checkbox"/> Gravel Packed, <input type="checkbox"/> Underreamed, <input type="checkbox"/> Telescoped, <input checked="" type="checkbox"/> Natural Development, <input type="checkbox"/> Open Hole, <input type="checkbox"/> Other (Describe)		
WELL GROUTED TO A DEPTH OF <u>10</u> FEET Type Grout (circle one): Cement, <u>Bentonite</u> , or Mix		

SCREEN DATA		
Diameter - Inches <u>2"</u>	Length - Feet <u>10'</u>	Slot Size - Inches <u>.008</u>
Screen Type <u>PVC</u>	Depth to Bottom - Feet <u>318'</u>	

RECEIVED	
MAY 05 2003	
BY: OLWR	
Top of Lap Pipe or Reduction in Casing	IF TELESKOPED OR MORE THAN ONE SCREEN: USE BACK PAGE
FEET	

I certify that the well was drilled, constructed and completed in accordance with all applicable Requirements of the Mississippi Department of Environmental Quality and/or the Mississippi Department of Health regulations and state laws.


Jack Ritzdell 472
Signature of Licensed Driller and License No.

4/30/03
Date

Additional Information Required On Back

If well telescopes please
sketch and show depths.

GROUND LEVEL

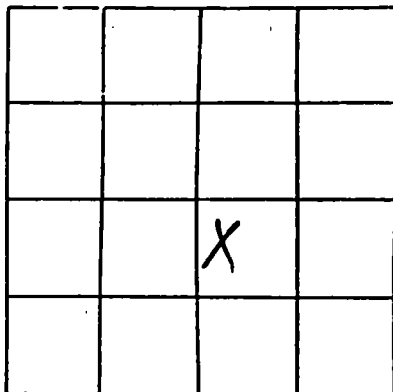

SECTION 8

Please indicate well location X.

Pump Capacity (GPM)	No. of Stages	Setting Depth
8	3	FT.

PUMP TEST

Well yielded _____ GPM with
a drawdown of _____ ft.
after _____ hours of pumping

LOG DATA

TYPE OF LOG RUN (Circle One): No Log Run.
Electric, Gamma Ray, Density, Sonic, Neutron,
Other (Describe) _____

Name of Organization Running Log

GEOLOGIC DATA (Office Use Only)

Surface Elev.	Geologic Unit	Unit Thickness	Depth to Top
Subs. SWL	Date	Analysis	Aquifer Test

Driller's Remarks

If more than one screen,
show location of each on sketch.