

MISSISSIPPI DEPARTMENT OF ENVIRONMENTAL QUALITY

Office of Land and Water Resources

P. O. Box 10631
Jackson, MS 39289-0631
WATER WELL DRILLERS LOG

COUNTY WELL LOCATED
JACKSON

WELL NUMBER
K-362

CODED

PERMIT NUMBER

DATE WELL COMPLETED
5-7-03

NAME OF DRILLING FIRM
Coast Water Well Service

NAME & MAILING ADDRESS OF LANDOWNER
Fleetwood Homes

Jolly Lane Lot 31

Latitude:

Longitude: **Vandeventer Ms**

WELL LOCATION: SEC **14** TOWNSHIP **6^N** RANGE **7^W**

DISTANCE **2** Miles DIRECTION **EAST** of NEAREST TOWN **Vandeventer**

OTHER LANDMARK

WELL PURPOSE: Home, Irrigation, Municipal, Industrial, Fish Pond, etc.

PUMP DATA

PUMP TYPE (Circle One):
Submersible, Turbine, Jet, Flowing Well,
Other (Describe) _____

POWER TYPE (Circle One):
 Electric, Tractor, Diesel, Gasoline, Butane,
Other (Describe) _____ H/P _____

DESCRIPTION OF FORMATIONS ENCOUNTERED	FROM	TO
Top Soil	0	2
Orange + White Clay	2	14
Pink + Orange Sand	14	35
Pink Clay	35	43
White coarse sand	43	65
White + pink Clay	65	85
White coarse sand	85	142

WELL DATA

Well Depth 142'	Casing Diameter (In.) 2"	Casing Length (Ft.) 132'
Type of Casing PVC	Hole Depth 142'	Depth to Static Water Level 25'

TYPE OF COMPLETION: (Circle One or More):
 Gravel Packed, Underreamed, Telescoped,
 Natural Development, Open Hole, Other
 (Describe) _____

WELL GROUTED TO A DEPTH OF **10** FEET
 Type Grout (circle one): Cement, Bentonite, or Mix

SCREEN DATA

Diameter - Inches 2"	Length - Feet 10'	Slot Size - Inches .008"
Screen Type PVC	Depth to Bottom - Feet 142'	

RECEIVED

MAY 19 2003

BY: OLWR

Top of Lap Pipe or Reduction in Casing

FEET IF TELESCOPED OR MORE THAN ONE SCREEN: USE BACK PAGE

I certify that the well was drilled, constructed and completed in accordance with all applicable Requirements of the Mississippi Department of Environmental Quality and/or the Mississippi Department of Health regulations and state laws.


Jack R. Rydell 472
Signature of Licensed Driller and License No.

5/15/03
Date

Additional Information Required On Back

If well telescopes please sketch and show depths.

GROUND LEVEL

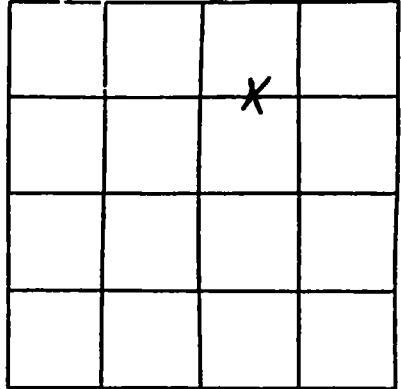

SECTION 14

Please indicate well location X.

Pump Capacity (GPM) <u>2.5</u>	No. of Stages <u>2</u>	Setting Depth FT.
-----------------------------------	---------------------------	--------------------------

PUMP TEST

Well yielded _____ GPM with
a drawdown of _____ ft.
after _____ hours of pumping

LOG DATA

TYPE OF LOG RUN (Circle One): No Log Run.
Electric, Gamma Ray, Density, Sonic, Neutron,
Other (Describe) _____

Name of Organization Running Log _____

GEOLOGIC DATA (Office Use Only)

Surface Elev.	Geologic Unit	Unit Thickness	Depth to Top
Subs. SWL	Date	Analysis	Aquifer Test

Driller's Remarks

If more than one screen, show location of each on sketch.