

MISSISSIPPI DEPARTMENT OF ENVIRONMENTAL QUALITY

Office of Land and Water Resources

P. O. Box 10631

Jackson, MS 39289-0631

WATER WELL DRILLERS LOG

COUNTY WELL LOCATED
Jackson

WELL NUMBER
W-392

CODED

DATE WELL COMPLETED
3-8-04

PERMIT NUMBER

NAME OF DRILLING FIRM
Const Water Well Service

NAME & MAILING ADDRESS OF LANDOWNER
Deanna Robertson
Jim Ramsey Rd.

Latitude:

Longitude: Vanleave, MS

WELL LOCATION: SEC 8 TOWNSHIP 6 N RANGE 7 W

DISTANCE 1 1/2 Miles DIRECTION W of NEAREST TOWN Vanleave

OTHER LANDMARK

WELL PURPOSE: Home, Irrigation, Municipal, Industrial, Fish Pond, etc.

PUMP DATA

PUMP TYPE (Circle One):
Submersible, Turbine, Jet, Flowing Well,
Other (Describe) _____

POWER TYPE (Circle One):
 Electric, Tractor, Diesel, Gasoline, Butane,
Other (Describe) _____ H/P 1

DESCRIPTION OF FORMATIONS ENCOUNTERED	FROM	TO
<u>Top Soil</u>	<u>0</u>	<u>2</u>
<u>Orange Clay</u>	<u>2</u>	<u>11</u>
<u>White Coarse Sand</u>	<u>7</u>	<u>35</u>
<u>Orange Clay</u>	<u>35</u>	<u>120</u>
<u>Brown Medium Sand</u>	<u>120</u>	<u>140</u>

WELL DATA

Well Depth 140' Casing Diameter (In.) 2" Casing Length (Ft.) 130'

Type of Casing PVC Hole Depth 140' Depth to Static Water Level 55'

TYPE OF COMPLETION: (Circle One or More):
 Gravel Packed, Underreamed, Telescoped,
 Natural Development, Open Hole, Other
(Describe) _____

WELL GROUTED TO A DEPTH OF 10 FEET
Type Grout (circle one): Cement, Bentonite, or Mix

SCREEN DATA

Diameter - Inches 2" Length - Feet 10' Slot Size - Inches .006

Screen Type PVC Depth to Bottom - Feet 140'

Top of Lap Pipe or Reduction in Casing

FEET IF TELESCOPED OR MORE THAN ONE SCREEN: USE BACK PAGE

I certify that the well was drilled, constructed and completed in accordance with all applicable Requirements of the Mississippi Department of Environmental Quality and/or the Mississippi Department of Health regulations and state laws.

Jack Reddell 472
Signature of Licensed Driller and License No.


3/16/04
Date

Additional Information Required On Back

RECEIVED
MAR 18 2004
BY: OLWR

If well telescopes please sketch and show depths.

GROUND LEVEL

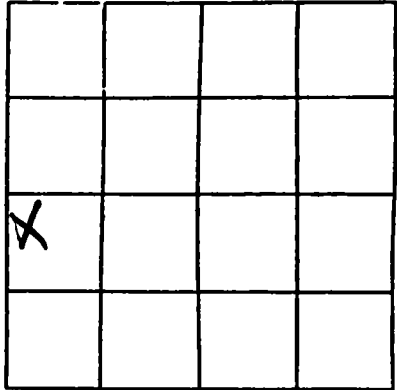

SECTION 8

Please indicate well location X.

Pump Capacity (GPM)	No. of Stages	Setting Depth	FT.
<u>7</u>	<u>2</u>		

PUMP TEST

Well yielded _____ GPM with
 a drawdown of _____ ft.
 after _____ hours of pumping

LOG DATA

TYPE OF LOG RUN (Circle One): No Log Run.
 Electric, Gamma Ray, Density, Sonic, Neutron,
 Other (Describe) _____

Name of Organization Running Log

GEOLOGIC DATA (Office Use Only)

Surface Elev.	Geologic Unit	Unit Thickness	Depth to Top
Subs. SWL	Date	Analysis	Aquifer Test

Driller's Remarks

If more than one screen,
 show location of each on sketch.