

MISSISSIPPI DEPARTMENT OF ENVIRONMENTAL QUALITY

Office of Land and Water Resources

P. O. Box 10631
Jackson, MS 39289-0631
WATER WELL DRILLERS LOG

COUNTY WELL LOCATED <u>COSHOCTON</u>	
WELL NUMBER <u>K 414</u>	CODED
DATE WELL COMPLETED <u>6-24-04</u>	

PERMIT NUMBER
NAME OF DRILLING FIRM <u>Coast Water Well Service</u>

NAME & MAILING ADDRESS OF LANDOWNER <u>Andy Hunt</u>			
<u>6000 D Wooded Acres Rd</u>			
Latitude:			
Longitude: <u>Vanceleve, MS</u>			
WELL LOCATION	SEC	TOWNSHIP	RANGE
	<u>20</u>	<u>6</u>	<u>7E</u>
DISTANCE	DIRECTION	NEAREST TOWN	
<u>2</u> Miles	<u>SOUTH</u>	<u>of Vanceleve</u>	
OTHER LANDMARK			
WELL PURPOSE: <input checked="" type="radio"/> Home Irrigation, <input type="radio"/> Municipal, <input type="radio"/> Industrial, <input type="radio"/> Fish Pond, etc.			

PUMP DATA	
PUMP TYPE (Circle One): Submersible, Turbine, <input checked="" type="radio"/> <u>381</u> Flowing Well, Other (Describe) _____	
POWER TYPE (Circle One): <input checked="" type="radio"/> Electric, Tractor, Diesel, Gasoline, Butane, Other (Describe) _____ H/P <u>1</u>	

DESCRIPTION OF FORMATIONS ENCOUNTERED	FROM	TO
<u>TOP SOIL</u>	<u>0</u>	<u>2</u>
<u>Orange Clay</u>	<u>2</u>	<u>18</u>
<u>Brown Coarse Sand</u>	<u>18</u>	<u>30</u>
<u>Orange + white clay</u>	<u>30</u>	<u>55</u>
<u>Brown Medium Sand</u>	<u>55</u>	<u>63</u>
<u>Orange Clay</u>	<u>63</u>	<u>100</u>
<u>Brown Coarse Sand</u>	<u>100</u>	<u>175</u>

WELL DATA		
Well Depth <u>175'</u>	Casing Diameter (In.) <u>2"</u>	Casing Length (Ft.) <u>165'</u>
Type of Casing <u>PVC</u>	Hole Depth <u>175'</u>	Depth to Static Water Level <u>40'</u>
TYPE OF COMPLETION: (Circle One or More): <input checked="" type="radio"/> Gravel Packed, <input type="radio"/> Underreamed, <input type="radio"/> Telescoped, <input checked="" type="radio"/> Natural Development, <input type="radio"/> Open Hole, <input type="radio"/> Other (Describe) _____		
WELL GROUTED TO A DEPTH OF <u>10</u> FEET Type Grout (circle one): <input checked="" type="radio"/> Cement, <input type="radio"/> Bentonite, or Mix		

SCREEN DATA		
Diameter - inches <u>2"</u>	Length - Feet <u>10'</u>	Slot Size - inches <u>.008</u>
Screen Type <u>PVC</u>	Depth to Bottom - Feet <u>175'</u>	

RECEIVED	
<u>JUL 12 2004</u>	
BY: OLWR	
<u>165x</u>	Top of Lap Pipe or Reduction in Casing
FEET	IF TELESCOPED OR MORE THAN ONE SCREEN: USE BACK PAGE

I certify that the well was drilled, constructed and completed in accordance with all applicable Requirements of the Mississippi Department of Environmental Quality and/or the Mississippi Department of Health regulations and state laws.


Jack Riggle 492
Signature of Licensed Driller and License No.

7/8/04
Date

Additional Information Required On Back

If well telescopes please sketch and show depths.

GROUND LEVEL

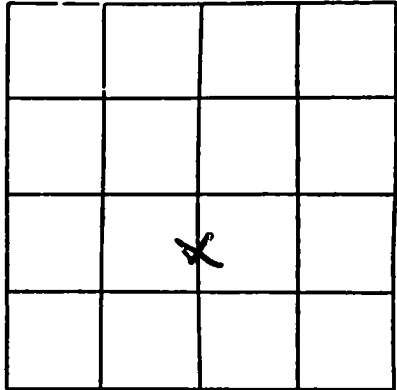

SECTION 20

Please indicate well location X.

Pump Capacity (GPM) <u>7.5</u>	No. of Stages <u>2</u>	Setting Depth FT.
-----------------------------------	---------------------------	--------------------------

PUMP TEST

Well yielded _____ GPM with
a drawdown of _____ ft.
after _____ hours of pumping

LOG DATA

TYPE OF LOG RUN (Circle One): No Log Run
Electric, Gamma Ray, Density, Sonic, Neutron,
Other (Describe) _____

Name of Organization Running Log _____

GEOLOGIC DATA (Office Use Only)

Surface Elev.	Geologic Unit	Unit Thickness	Depth to Top
Subs. SWL	Date	Analysis	Aquifer Test

Driller's Remarks

If more than one screen,
show location of each on sketch.