

# State Well Report

## Part 1

Mississippi Department of Environmental Quality  
Office of Land and Water Resources  
P.O. Box 10631  
Jackson, MS 39289-0631  
(601)961-5210  
(601)354-6938 (fax)

For Office Use Only:

Aquifer: \_\_\_\_\_  
Well #: K-420  
L. S. Elevation: \_\_\_\_\_  
E-log #: \_\_\_\_\_

County: JACKSON  
Permit #: \_\_\_\_\_  
Driller: COASTWATER Well Service  
Date drilling completed: 8-3-04

State Law requires that this report be prepared by the driller in detail and filed with the Department within 30 days of completion of drilling of the well.

Well Owner Information	Well Location
Owner Name: <u>JAMES TIBILIER</u>	Latitude: <u>30.31.900</u> Longitude: <u>88.42.001</u>
Mailing Address: <u>14105 SEAMAN RD</u>	Method of Lat/Long (circle one): <u>Conventional Survey</u>
<u>VANLEAVE, MS. 39565</u>	USGS quad: <u>(Hand-held GPS)</u> Survey-grade GPS
City: _____ State: _____ Zip Code: _____	<u>S 1/4 SE 1/4 Sec 8</u> Twn <u>T6S</u> Rng <u>R7W</u>
Telephone No. <u>(228) 826-2536</u>	Distance: _____ Direction: <u>WEST</u> Nearest Town: <u>VANLEAVE</u>

### Well Data

Purpose of Well (circle one) Home Industrial Public Supply Irrigation Fish Culture Other: \_\_\_\_\_  
Date well drilling started: 8-3-04 Date well drilling completed: 8-3-04  
If flowing, method of flow regulation: Valve N/A Other (describe) \_\_\_\_\_  
Static Water Level: 45 feet above or below (circle one) land surface Date measured: 8-3-04  
Method of Measurement (circle one) steel tape electric tape air line other: \_\_\_\_\_  
Hole depth: 105' Well depth: 105' Well grouted to a depth of 10 feet  
Type of grout (circle one): Cement Bentonite Mix  
Casing length: 95' feet Casing diameter: 2 inches Type of casing: F480 PVC SCH 40  
Screen length: 10 feet Screen diameter: 2 inches Type of screen: PVC-WOP  
Screen slot size: 1004 inches Setting depth: From 95 feet to 105 feet  
Type of completion (circle all applicable): Gravel packed Underreamed Telescoped Open hole Natural Development  
Other (describe): \_\_\_\_\_  
Top of lap pipe or reduction in casing: N/A feet. If telescoped or more than one screen, describe on back of page  
Logs run (circle all applicable): No log run Electric Gamma Ray Density Sonic Neutron Other: \_\_\_\_\_  
Name of organization running log(s): N/A

I certify that the well was drilled, constructed, and completed in accordance with all applicable requirements of the Mississippi Department of Environmental Quality and/or the Mississippi Department of Health regulations and state laws.

JACK RIDGELL 0-472  
Print Name of Water Well Contractor and License No.

Jack Ridgell  
Signature of Water Well Contractor

RECEIVED  
AUG 19 2004  
BY: OLWR

If well telescopes please sketch below and show depths.


Ground Level

K-420

Description of Formations Encountered	From	To
TOP Soil	0	2
Orange clay	2	11
Brown Sand	11	23
Orange + White Sand	23	65
Brown Medium Sand	65	105

If more than one screen, show location of each on sketch

Sketch the property layout and include the following: 1) the well location; 2) any permanent structures on the property that may aid in locating the well; 3) any roads, power lines, or other items that may aid in locating the property and the well; 4) indicate direction.

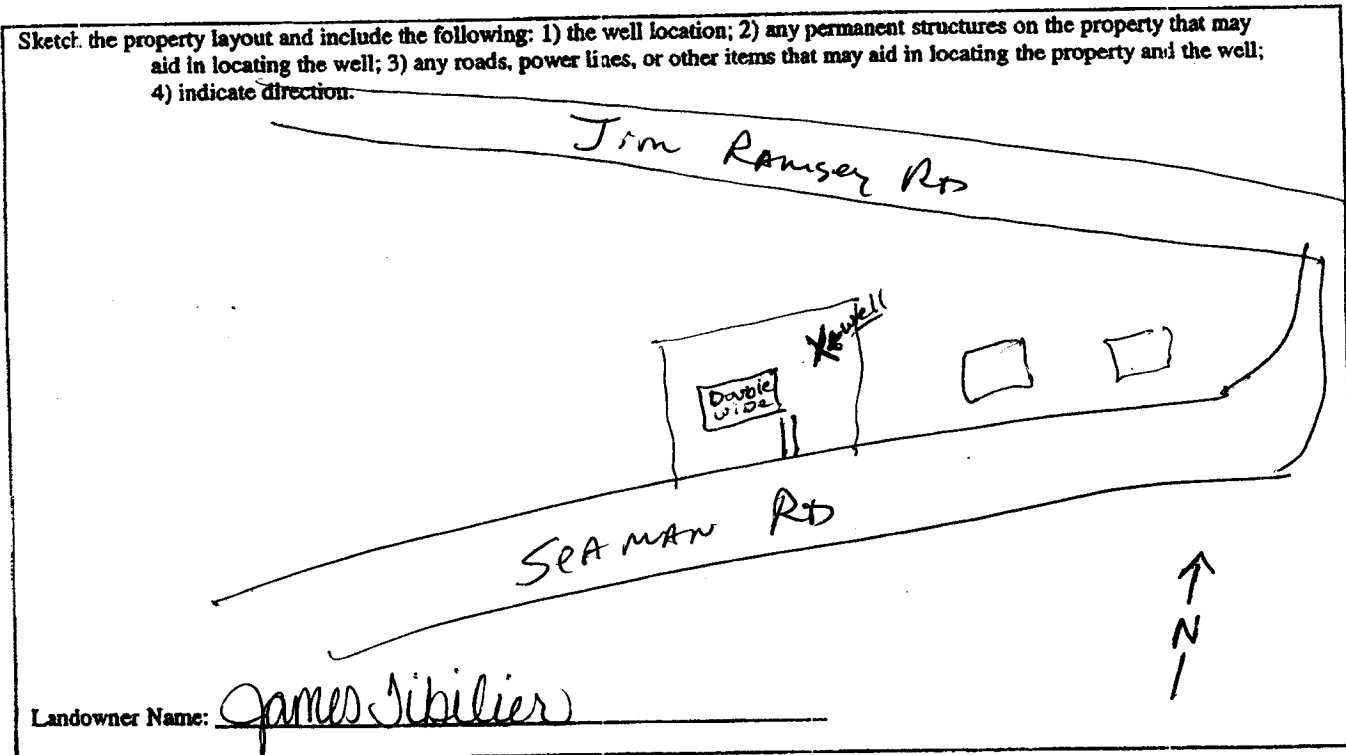

Landowner Name: James Sibilier

Jack Reddell  
Signature of Water Well Contractor

RECEIVED  
AUG 13 2004  
BY: OLWR

# STATE WELL REPORT

## Part 2

**Pump Installer's Completion Report**  
 Mississippi Department of Environmental Quality  
 Office of Land and Water Resources  
 P.O. Box 10631  
 Jackson, MS 39289-0631  
 (601)961-5210  
 (601)354-6938 (fax)

For Office Use Only:

Aquifer: \_\_\_\_\_

Well #: K-420

Elevation: \_\_\_\_\_

County JACKSON  
 Permit #: \_\_\_\_\_  
 Driller: COAST WATER WELL  
 Date completed: 8-4-04

This report should be prepared by the pump installer in detail and filed with the Department within 30 days of the installation of pump.

Well Owner Information	Well Location
Owner Name: <u>JAMES Tibbick</u>	Latitude: <u>30° 31.900</u> Longitude: <u>088° 42.001</u>
Mailing Address: <u>14105 SEAMAN RD.</u>	Method of Lat/Long (circle one): Conventional Survey,
<u>Vanderve, Ms. 39565</u>	USGS quad, <u>Hand-held GPS</u> , Survey-grade GPS
City State Zip Code	<u>S 1/4 SE 1/4 Sec B Twn T6S Rng R7W</u>
Telephone No. <u>(228) 826-2536</u>	Distance Direction Nearest Town
	<u>1 Miles WEST of Vanderve</u>

Pump Type Circle one	Power Type Circle one
Air Lift <input checked="" type="radio"/> <u>Jer</u> Submersible	Diesel Engine Gasoline Engine Natural Gas
Bucket Piston Turbine	<input checked="" type="radio"/> <u>Electric Motor</u> Hand Tractor PTO
Centrifugal Rotary Flowing Well	Windmill Other (specify): _____
Other (specify): <u>1 HP Goulds SI-10</u>	Horse Power Rating of Motor: <u>1 HP</u>
Date Pump Installed: <u>8-4-04</u>	Setting Depth: <u>60' drop pipe</u> feet
Rated Pump Capacity: <u>7.5</u> Gallons Per Minute	Number of Stages: <u>2</u>

Pump Test Data	Method of Measuring Water Level Circle one
Date Well Tested: <u>8-4-04</u>	<input checked="" type="radio"/> <u>Air Line</u> Electric Measuring Line Steel Tape
Static Water Level (A): <u>45'</u> Feet Below Land Surface	Other (specify): _____
Pumping Water Level (B): <u>N/A</u> Feet Below Land Surface	For flowing well, measured shut in head: <u>N/A</u> feet
Drawdown [(B) - (A)]: <u>N/A</u> Feet Below Land Surface	Well yielded <u>7.5</u> GPM with a drawdown of
Test Pumping Rate: <u>7.5</u> Gallons Per Minute	_____ feet after _____ hours of pumping
Duration of Pump Test (minimum 4 hours): _____ hours	

I HEREBY CERTIFY that the above statements are true to the best of my knowledge.

JOHNNY ELKINS \_\_\_\_\_  
 Print Name of Pump Installer and License No. (if applicable) Signature of Pump Installer

RECEIVED

AUG 19 2004

BY: OLWR