
, T -		
County: Jackson 059	State Well Report Part 1	For Once Use On
Permit #:	sissippi Department of Environn Office of Land and Water Res	
Driller Wast WAter Well Srv	P.O. Box 10631 Jackson, MS 39289-063	
Date drilling completed: 1-6-05	(601)961-5210	E-log #:
	(601)354-6938 (fax)	
State Law requires that this report b 30 days of completion of drilling of th	e prepared by the driller in de he well.	ail and filed with the Department with
Well Owner Information		Well Location
Owner Name Charles Brownin	Latitude: 3) • 31,911 " Longitude: 088 43,
Mailing Address: Little Blu		at/Long (circle one): Conventional Survey,
		quad, Hand-held GPS Survey-grade GPS
Vancleave Ms.	<u>39565</u> <u>SE % 3</u> Zip Code	ω₄ Sec_7Twn <u>_765_</u> Rng <u>k</u>
Telephone No. $(328) & 219 - 6304$	Distance	les <u>West</u> of <u>Vanclease</u>
Telephone Ivo. (201) Carrent Leven	Well Data	
Purpose of Well (circle one) Home Industria		Fish Culture Other:
Date well drilling started: $1 - 6 - c$	<u>.</u>	
If flowing, method of flow regulation: Valve		
Static Water Level: <u>80</u> feet above	or below (circle one) land surface	Date measured: $1 - 6 - 05$
Method of Measurement (circle one) steel ta	ape electric tape air line	other:
Hole depth: 315' Well depth:	<u>315'</u> Well groute	d to a depth of <u>10</u> feet
Type of grout (circle one): Cement	entonite Mix	
Casing length: <u>300</u> feet Casing dia	ameter: 2 inches	Type of casing: $\underline{\rho VC}$
Screen length: 15 feet Screen di	ameter: <u>2</u> inches 7	ype of screen:
Screen slot size: <u>OCCo</u> inches S	Setting depth: From <u>300</u>	_feet to
Type of completion (circle all applicable): Gr	avel packed Underreamed Tel	escoped Open hole Natural Developm
Ot	ther (describe):	
Top of lap pipe or reduction in casing: N	feet. If telescoped or m	ore than one screen, describe on back of
Logs run (circle all applicable): No log run E	Electric Gamma Ray Density S	onic Neutron Other:
Name of organization running log(s): N A I certify that the well was drilled, constructed	d. and completed in accordance w	th all applicable requirements of the Mis
Department of Environmental Quality and/o		
JackRidgdell 0-47:	C	Jul hilder

If well telescopes please sketch below and show depths.

.

	Description of Formations Encountered	From	То
Ground Level K - 449	Topsoil	ρ	2
	orange clay	$\boldsymbol{\beta}$	18
	Brown Coarbe Sand	18	34
	prange + white Clay	34	TOO
	Brown Course Sand	100	120
	Blue Clay	120	290
	Gray medium Sand	290	315
			_
			ļ
			L
			<u> </u>
			<u> </u>
			┝───
			
			L

If more than one screen, show location of each on sketch

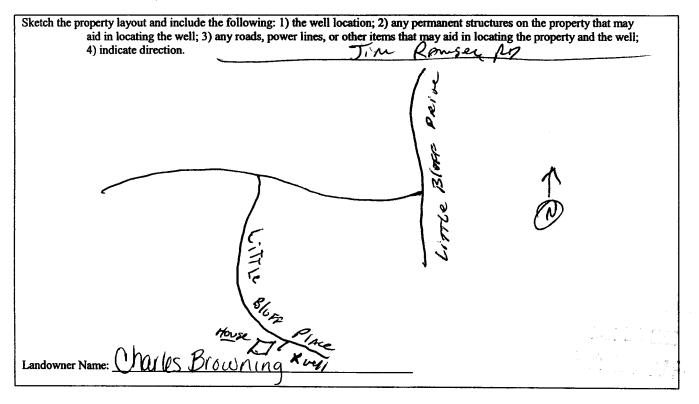

lue Signature of Water Well Contractor

,			ELL REPORT	
County: <u>Jack Son</u> Permit #:		Pump Installer' Mississippi Departmer	art 2 s Completion Report nt of Environmental Quality and Water Resources	For Office Use Only: Aquifer:
Driller: Coast Water Date completed: 1-6	Wellservic-e	Jackson, M (601)	Box 10631 AS 39289-0631)961-5210 i4-6938 (fax)	Well #: <u>K- 449</u> Elevation:
This report shoul	d be prepared by		il and filed with the Departm	ent within 30 days of the
installation of pur W	mp. ell Owner Inform:	ation	We	Il Location
Owner Name: Cha	٩		Latitude: 30° 31' 911'	Longitude: 188° 43' 632'
Mailing Address: Li Hle Bluff Place		Method of Lat/Long (circle one): Conventional Survey,		
			USGS quad, (Hand	d-held GPS, Survey-grade GPS
Vancleave MS 37565 City State Zip Code		SW 14 SW 14 Sec_	Twn T65 Rng R7W	
City	State	Zip Code	Distance Direction	Nearest Town
Telephone No. 238)	219-630	4	<u>A</u> Miles <u>WEST</u>	of Vancleave
	Pump Type Circle one			ower Type Circle one
Air Lift	(Jet)	Submersible	Diesel Engine Gasoli	ne Engine Natural Gas
Bucket	Piston	Turbine	(Electric Motor) Hand	-
Centrifugal	Rotary	Flowing Well	Windmill Other	(specify):
Other (specify):				r_2HP
Date Pump Installed:		4	Setting Depth: 100 Dr	
Rated Pump Capacity:			Number of Stages:3	
	Pump Test Data			easuring Water Level
Date Well Tested:	2-7-04			Circle one
Static Water Level (A)	: <u>80</u> Fee	et Below Land Surface		asuring Line Steel Tape
Pumping Water Level	(B): <u>N/A</u> Fee	t Below Land Surface	Other (specify):	
Drawdown [(B) – (A)]	,		For flowing well, measured s	hut in head: <u>N/A</u> feet
Test Pumping Rate:	9,5	_Gallons Per Minute	Well yielded 9.5	GPM with a drawdown of
Duration of Pump Test	(minimum 4 hours): <u> </u>	N/A feet after_	NA hours of pumping
		······		
Mulid N	$1 \wedge i \circ \wedge i$	ments are true to the best of -714P	Dan	RECEIVED
Print Name of Pump In	staller and License	No. (if applicable)	Signature of Pump I	

•

BY:	OL	WR	
-----	----	----	--