		ell Report	For Office Use Only:	
County: JACKSON		art 1	Aquifer:	
Permit #:	Mississippi Department of Environmental Quality Office of Land and Water Resources		Well #: K- 497	
Driller: COOSt Water Well STV.	P.O. Box 10631			
Date drilling completed: 2-25-06	Jackson, MS 39289-0631 (601)961-5210		L. S. Elevation:	
(601)354		-6938 (fax)	E-log #:	
State Law requires that this repo 30 days of completion of drilling	ort be prepared by the of the well.	driller in detail and filed w	ith the Department within	
Well Owner Information		Well	Location	
Owner Name William Sloan		Latitude: 30 • 32 · 024	f" Longitude <u>088 • 43</u> . 447, 26	
Mailing Address: 13608 COUNTry Trail		Method of Lat/Long (circle or	ne): Conventional Survey,	
V		USGS quad, (Hand-held	GPS, Survey-grade GPS	
Vancleave ms 39545 City State Zip Code		5w 1/ SE 1/4 Sec 7	Twn T65 Rng R7W	
City State Zip Code		Distance Direction	Nearest Town	
Telephone No. (200) 267 - 4396		Distance Direction 2 Miles	of Vonclear	
	Well I	Jata		
Purpose of Well (circle one Home Industrial Public Supply Irrigation Fish Culture Other:				
Date well drilling started: $2 \cdot 34 \cdot 06$ Date well drilling completed: $3 \cdot 35 - 06$				
If flowing, method of flow regulation: Val	ve NA Other (d	escribe)		
Static Water Level: <u>95</u> feet ab	ove or below (circle one) l	and surface Date measured:	2-25-06	
Method of Measurement (circle one) steel tape electric tape air line other:				
Hole depth: <u>310</u> Well dep	th: <u>310'</u>	Well grouted to a depth of	feet	
	Bentonite Mix			
Casing length: <u>295</u> feet Casing diameter: <u>2</u> inches Type of casing: <u>PNC</u>				
Screen length: 15 feet Screen diameter: 2 inches Type of screen: DVC				
Screen slot size:				
Type of completion (circle all applicable): Gravel packed Underreamed Telescoped Open hole Natural Development				
	Other (describe):	······································		
Top of lap pipe or reduction in casing:	IAfeet. If tel	escoped or more than one scr	een, describe on back of page	
Logs run (circle all applicable) No log rur	Electric Gamma Ray	Density Sonic Neutron	Other:	
Name of organization running log(s):	NIA			
I certify that the well was drilled, construct Department of Environmental Quality a	•			
Debartment of PRAROUMENTAL Anality a	na ai ar mississippi Del	sai timent of ficatin regulation		
Jack eidgdell 0-4	72	fach	Kidghill	
Print Name of Water Well Contractor and	License No.	Signature of	Water Well Contractor	
			RECEIVE	
			المعرف المعالم	

•


MAR 2 3 2006 BY: OLWR

K-497

If well telescopes please sketch below and show depths.

Ground Level	Description of Formations Encountered	From	To
	Orange Clay Browry (Darse San of Orange Clay wistreaus of san Blue Clay Gray Coarse Sand	18 18 188 188 270	18 28 188 270 310

If more than one screen, show location of each on sketch

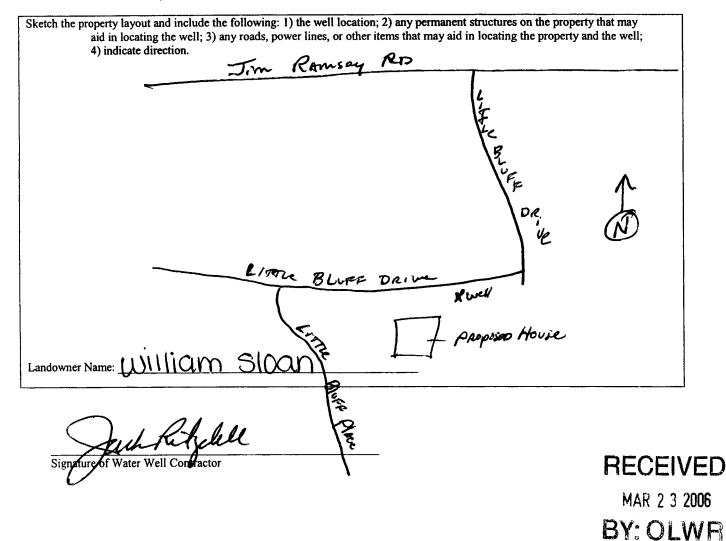

STATE WELL REPORT					
County: <u>Jackson</u> Permit #: <u>Mississippi Departme</u> Office of Land Problem VellSRY, P.O. Jackson, (601	Part 2 For Office Use Only: 's Completion Report Aquifer: and Water Resources Main Say Seg-0631 Box 10631 Well #: <u>K-9972</u> Up61-5210 Elevation:				
This report should be prepared by the pump installer in detail and filed with the Department within 30 days of the installation of pump.					
Well Owner Information	Well Location				
Owner Name: William Sloan	Latitude: <u>30° 32' (02) 1'</u> Longitude: <u>088° 43' 44</u> 7'				
Mailing Address: 13608 COUNTRY TRAIT	Method of Lat/Long (circle one): Conventional Survey,				
	USGS quad, Hand-held GPS Survey-grade GPS				
LANCI LAVE MS 39545 City State Zip Code	SW 1/ SE 1/ Sec_7_TWn TLDS Rng PTW				
	Distance Direction Nearest Town				
Telephone No. (700,207-4390	Miles West of Van Cleave				
Ритр Туре	Power Type				
Circle one	Circle one				
Air Lift Jet Submersible	Diesel Engine Gasoline Engine Natural Gas				
Bucket Piston Turbine	Electric Motor Hand Tractor PTO				
Centrifugal Rotary Flowing Well	Windmill Other (specify):				
Other (specify):	Horse Power Rating of Motor:				
Date Pump Installed: 4-20-00	Setting Depth: 20 Ft DOP Dip C feet				
Rated Pump Capacity: 8.5 Gallons Per Minute	Number of Stages:3				
Pump Test Data Date Well Tested: 4 - 20 - 00	Method of Measuring Water Level Circle one				
Static Water Level (A): Feet Below Land Surface	Air Line Electric Measuring Line Steel Tape				
Pumping Water Level (B): NA Feet Below Land Surface	Other (specify):				
Drawdown [(B) - (A)]: N/A Feet Below Land Surface	For flowing well, measured shut in head: <u>NA</u> feet				
Test Pumping Rate: 83 Gallons Per Minute	Well yielded <u><u>8.5</u> GPM with a drawdown of</u>				
Duration of Pump Test (minimum 4 hours):hours	NA feet after NA hours of pumping				
I HEREBY CERTIFY that the above statements are true to the best of my knowledge.					
Tack Ridge CII 0-972 Print Name of Pump Installer and License No. (if applicable)	Signature of Pump Installer RECEIVED				
	MAY 17 2006				
	BY: OLWR				

c

r