	Part 1		
County: JACKSON			For Office Use Only
	Mississippi Department of Er Office of Land and Wa		Aquifer:
Permit #: Driller: Ceast Water Well SRV.	P.O. Box 10		Well #: K- 500
	Jackson, MS 392	89-0631	L. S. Elevation:
Date drilling completed: 3-30-06	(601)961-52 (601)354-6938		E les #
	s (Iax)	E-log #:	
State Law requires that this rep	ort be prepared by the drille	r in detail and filed w	ith the Department wit
30 days of completion of drilling		XX/all	Location
Well Owner Inform			
Owner Name Ted Rice			" Longitude: 085 4/
Mailing Address: 5101 C.L.D	Mailing Address: <u>STOLC.L.Dees RD</u> Method of Lat/		
		USGS quad Hand-held	GPS Survey-grade GPS
Vancleave,	Ms 39564 MW	1/4 NW 1/4 Sec28	Twn T65 RngR7
City Sta	tte Zip Code	nce Direction	Nearest Town
Telephone No. (228) 336 - 434	He 2	Miles So JTH	
·····	Well Data		
\frown			
Purpose of Well (circle one) Home Ind			Other:
Date well drilling started: 3-20)-OQ Date well dri	lling completed: $3 - 3$	20-06
If flowing, method of flow regulation: Va	lve N/A Other (describe	:)	
Static Water Level: <u>60</u> feet al			
Method of Measurement (circle one) s	teel tape electric tape a	ir line other:	
Hole depth: <u>336'</u> Well de	pth: <u>336'</u> Wel	I grouted to a depth of	10 feet
Type of grout (circle one): Cement	Bentonite Mix		
Casing length: 326 feet Casi	ng diameter:	es Type of casing:	PVC
		es Type of screen:	
Screen slot size: • 008 inches	Setting depth: From32	<u>26 feet to 3.</u>	<u>36</u> feet
Type of completion (circle all applicable):	Gravel packed Underreamed	l Telescoped Open	hole Natural Developm
	Other (describe):		
Top of lap pipe or reduction in casing:	NA feet. If telescope	ed or more than one scr	een, describe on back of p
Logs run (circle all applicable): No log ru	Electric Gamma Ray Dens	sity Sonic Neutron	Other:
Name of organization running log(s):	NA		
I certify that the well was drilled, constr	•	••	•
Department of Environmental Quality :	and/or the Mississippi Departme	ent of Health regulation	s and state laws.
-			
JackRidgdell 0-4-	72	Jach	Kidgall

APR 1 0 2006 BY: OLWR


K- 500

If well telescopes please sketch below and show depths.

Ground Level

		From	10
 	Top Soil	0	a
	orange Class	2	70
	Prown narse Sand	10	25
	Gray Clay WStreaks OF Sand	25	76
	White Coarse Sand	At	ШŤ.
		THE.	166
	BlueClay Gray Coarse Sand	ASS.	91/
	stay ou se sara	P 77.	37 0
	3		
			ļ
			<u> </u>
			<u> </u>
1			<u> </u>
			_

If more than one screen, show location of each on sketch

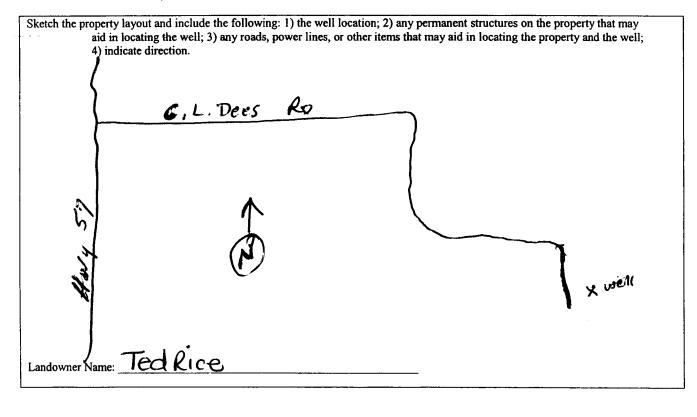

Signature of Water Well Contractor

APR 1 0 2006 BY: OLWR

		STATE W	ELL REPORT		
County: JACK Permit #: Driller: COAST U Date completed: 3-	Vaterwellsk	Pump Installer ³ Mississispi Departmer Office of Land P.O. Jackson, R (601	Part 2 s Completion Report nt of Environmental Quality and Water Resources Box 10631 MS 39289-0631)961-5210 54-6938 (fax)	For Office Use Only: Aquifer:	
] he pump installer in det	ail and filed with the Departm	ent within 30 days of the	
installation of pump. Well Owner Information			Well Location		
Owner Name: TEC Rice			Latitude: 30°27'684" Longitude: 088°41'459"		
Mailing Address: 5101 C. L. Dees Rd			Method of Lat/Long (circle one): Conventional Survey, 27		
			USGS quad, Hand-held GPS Survey-grade GPS		
Vancleave Ms 39565 City State Zip Code			NW 1/4 NW 1/4 Sec 28 Twn T65 Rng R7W		
C	ity State	Zip Code	Distance Direction Nearest Town		
Telephone No. (23	18326-42	46	2 Miles South	of Vanchepre	
	Pump Type		P	ower Type	
	Circle one			Circle one	
Air Lift	Jet	Submersible	Diesel Engine Gasol	ine Engine Natural Gas	
Bucket	Piston	Turbine	Electric Motor Hand	Tractor PTO	
Centrifugal	Rotary	Flowing Well		(specify):	
Other (specify):			4	r: <u>1HP</u>	
Date Pump Installed: 3-22-06			Setting Depth: 80FT. Droppipes feet		
Rated Pump Capacit	ty: <u>8</u>	_Gallons Per Minute	Number of Stages:	2	
	Pump Test Data			easuring Water Level Circle one	
Date Well Tested:	3-22-06				
Static Water Level (A):Feet Below Land Surface			easuring Line Steel Tape		
Pumping Water Lev	el (B): NA Fee	t Below Land Surface	Outer (apeerry)		
Drawdown [(B) - (A	A)]: NA Fee	t Below Land Surface	For flowing well, measured	shut in head:N/Afeet	
Test Pumping Rate: Gallons Per Minute				GPM with a drawdown of	
Duration of Pump T	est (minimum 4 hours): <u> </u>	N/A feet after	N/A_hours of pumping	
Johnel	FY that the above state <u>Kins</u> 0-7 p Installer and License		of my knowledge.	Installer RECEIVE	
			1	APR 1 0 2006	
				BY: OLW	

•