

# State Well Report

## Part 1

Mississippi Department of Environmental Quality  
 Office of Land and Water Resources  
 P.O. Box 10631  
 Jackson, MS 39289-0631  
 (601)961-5210  
 (601)354-6938 (fax)

### For Office Use Only:

Aquifer: \_\_\_\_\_  
 Well #: K-505  
 L. S. Elevation: \_\_\_\_\_  
 E-log #: \_\_\_\_\_

County: JACKSON  
 Permit #: \_\_\_\_\_  
 Driller: Coastwater Well Sv.  
 Date drilling completed: 3-30-06

State Law requires that this report be prepared by the driller in detail and filed with the Department within 30 days of completion of drilling of the well.

Well Owner Information			Well Location	
Owner Name: <u>Richard Sowers</u>			Latitude: <u>30° 32' 13.1"</u>	Longitude: <u>088° 40' 120.7"</u>
Mailing Address: <u>P.O. BOX 5234</u>			Method of Lat/Long (circle one): Conventional Survey,	
			USGS quad, <u>Hand-held GPS</u> , Survey-grade GPS	
			<u>SE 1/4 NE 1/4 Sec 10</u> Twn <u>T6S</u> Rng <u>R7W</u>	
City	State	Zip Code	Distance	Direction
			<u>1 1/2</u> Miles	<u>East</u> of
Telephone No. <u>288 282-3990</u>			Nearest Town <u>Umclane</u>	

**Well Data**

Purpose of Well (circle one) Home Industrial Public Supply Irrigation Fish Culture Other: \_\_\_\_\_

Date well drilling started: 3-30-06 Date well drilling completed: 3-30-06

If flowing, method of flow regulation: Valve N/A Other (describe) \_\_\_\_\_

Static Water Level: 40 feet above or below (circle one) land surface Date measured: 3-30-06

Method of Measurement (circle one) steel tape electric tape air line other: \_\_\_\_\_

Hole depth: 124 Well depth: 124 Well grouted to a depth of 10 feet

Type of grout (circle one): Cement Bentonite Mix

Casing length: 114 feet Casing diameter: 2 inches Type of casing: PVC

Screen length: 10 feet Screen diameter: 2 inches Type of screen: PVC

Screen slot size: .006 inches Setting depth: From 114 feet to 124 feet

Type of completion (circle all applicable): Gravel packed Underreamed Telescoped Open hole Natural Development

Other (describe): \_\_\_\_\_

Top of lap pipe or reduction in casing: \_\_\_\_\_ feet. If telescoped or more than one screen, describe on back of page

Logs run (circle all applicable): No log run Electric Gamma Ray Density Sonic Neutron Other: \_\_\_\_\_

Name of organization running log(s): N/A

I certify that the well was drilled, constructed, and completed in accordance with all applicable requirements of the Mississippi Department of Environmental Quality and/or the Mississippi Department of Health regulations and state laws.

Jack Ridgell 0-492  
 Print Name of Water Well Contractor and License No.


Jack Ridgell  
 Signature of Water Well Contractor

RECEIVED  
 MAY 03 2006  
 BY: OLWR

If well telescopes please sketch below and show depths.

K-505


Ground Level

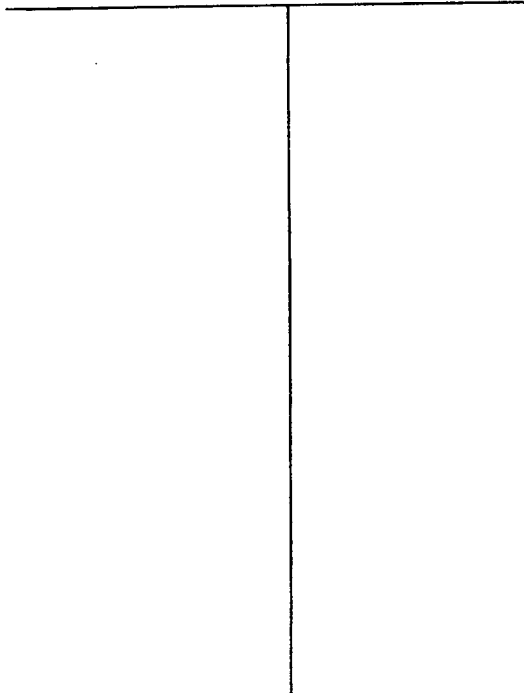

Description of Formations Encountered	From	To
TOP SOIL	0	2
red clay	2	14
white coarse sand	14	21
Blue clay	21	05
medium white sand	05	24

If more than one screen, show location of each on sketch

Sketch the property layout and include the following: 1) the well location; 2) any permanent structures on the property that may aid in locating the well; 3) any roads, power lines, or other items that may aid in locating the property and the well; 4) indicate direction.

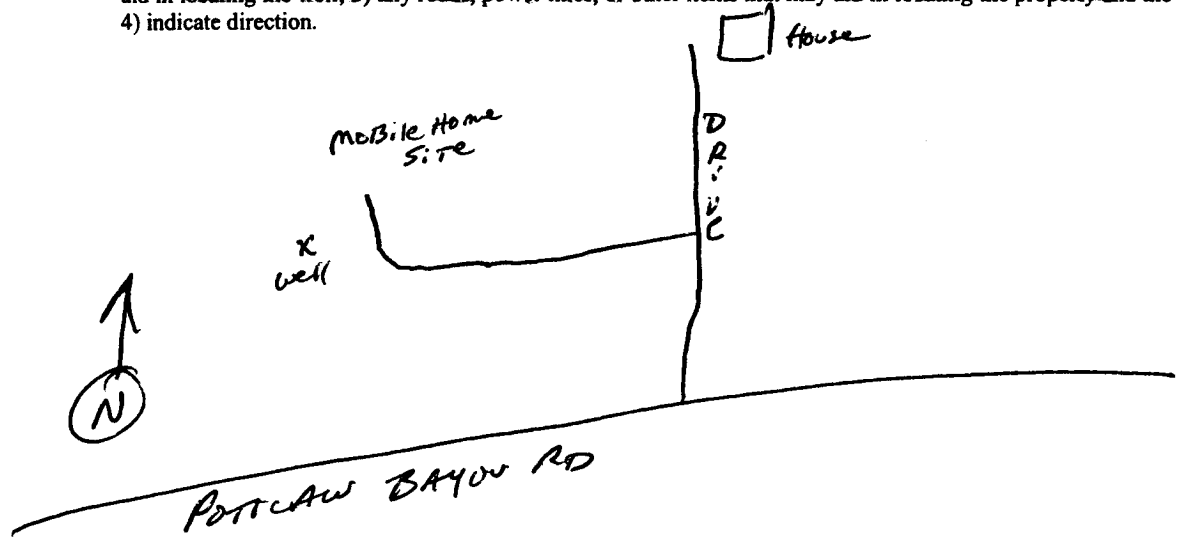

Landowner Name: Richard SOWERS

Jack Ritzdell  
Signature of Water Well Contractor

RECEIVED  
MAY 03 2006  
BY: OLWR

# STATE WELL REPORT

## Part 2

**Pump Installer's Completion Report**  
 Mississippi Department of Environmental Quality  
 Office of Land and Water Resources  
 P.O. Box 10631  
 Jackson, MS 39289-0631  
 (601)961-5210  
 (601)354-6938 (fax)

County: Jackson  
 Permit #: \_\_\_\_\_  
 Driller: CoastWaterWellSRV  
 Date completed: 3-30-06

For Office Use Only:

Aquifer: \_\_\_\_\_  
 Well #: H-505  
 Elevation: \_\_\_\_\_

This report should be prepared by the pump installer in detail and filed with the Department within 30 days of the installation of pump.

Well Owner Information	Well Location
Owner Name: <u>Richard Sowers</u>	Latitude: <u>30°32'139"</u> Longitude: <u>088°40'120"</u>
Mailing Address: <u>P.O. BOX 5234</u>	Method of Lat/Long (circle one): Conventional Survey, USGS quad, <u>(Hand-held GPS)</u> , Survey-grade GPS
<u>Vanceleve Ms. 39565</u>	<u>SE</u> ¼ <u>NE</u> ¼ Sec <u>10</u> Twn <u>T6S</u> Rng <u>R7W</u>
City State Zip Code	Distance Direction Nearest Town
Telephone No. <u>(601) 282-3990</u>	<u>1 1/2</u> Miles <u>EAST</u> of <u>Vanceleve</u>

Pump Type Circle one	Power Type Circle one
Air Lift <input type="checkbox"/> Jet <input checked="" type="checkbox"/> Submersible <input type="checkbox"/>	Diesel Engine <input type="checkbox"/> Gasoline Engine <input type="checkbox"/> Natural Gas <input type="checkbox"/>
Bucket <input type="checkbox"/> Piston <input type="checkbox"/> Turbine <input type="checkbox"/>	<u>Electric Motor</u> <input checked="" type="checkbox"/> Hand <input type="checkbox"/> Tractor PTO <input type="checkbox"/>
Centrifugal <input type="checkbox"/> Rotary <input type="checkbox"/> Flowing Well <input type="checkbox"/>	Windmill <input type="checkbox"/> Other (specify): _____
Other (specify): _____	Horse Power Rating of Motor: <u>1 HP</u>
Date Pump Installed: <u>4-5-06</u>	Setting Depth: <u>40 ft. droppipe</u> feet
Rated Pump Capacity: <u>8</u> Gallons Per Minute	Number of Stages: <u>2</u>

Pump Test Data	Method of Measuring Water Level Circle one
Date Well Tested: <u>4-5-06</u>	<u>Air Line</u> <input checked="" type="checkbox"/> Electric Measuring Line <input type="checkbox"/> Steel Tape <input type="checkbox"/>
Static Water Level (A): <u>40</u> Feet Below Land Surface	Other (specify): _____
Pumping Water Level (B): <u>N/A</u> Feet Below Land Surface	For flowing well, measured shut in head: <u>N/A</u> feet
Drawdown [(B) - (A)]: <u>N/A</u> Feet Below Land Surface	Well yielded <u>8</u> GPM with a drawdown of
Test Pumping Rate: <u>8</u> Gallons Per Minute	<u>N/A</u> feet after <u>N/A</u> hours of pumping
Duration of Pump Test (minimum 4 hours): <u>16</u> hours	

I HEREBY CERTIFY that the above statements are true to the best of my knowledge.

Jack Riddell 0-472 Jack Riddell  
 Print Name of Pump Installer and License No. (if applicable) Signature of Pump Installer

RECEIVED

MAY 03 2006

BY: OLWR