
State W	ell Report	For Office Use Only:		
	Thekson Part 1			
	Mississippi Department of Environmental Quality			
P.0. Box 10031		Well #: <u>K-515</u> L. S. Elevation:		
Jackson, M	Jackson, MS 39289-0631 (601)961-5210			
(601)354	(601)354-6938 (fax)			
State Law requires that this report be prepared by the driller in detail and filed with the Department within 30 days of completion of drilling of the well.				
Well Owner Information		Location		
Owner Name WALLACE EASLEY	70	[" Longitude. <u>(88•41 '615</u> " 37		
Mailing Address:	Method of Lat/Long (circle or			
	USGS quad Hand-held	GPS Survey-grade GPS		
Vancleave 1115 39565 City State Zip Code	<u>NW 1/2 NW 1/2 Sec_2/</u>	Twn TGS Rng R7W		
Telephone No. 008 219 - 2535	Distance Direction	Nearest Town of <u>Vancleance</u>		
Well I	Data			
Purpose of Well (circle one) Home Industrial Public Supply Irrigation Fish Culture Other:				
Date well drilling started: 6-20-06 Date well drilling completed: 6-20-06				
If flowing, method of flow regulation: Valve Other (describe)				
Static Water Level: <u>50</u> feet above on below (circle one) land surface Date measured: <u>6-30-06</u>				
Method of Measurement (circle one) steel tape electric tape air line other:				
Hole depth: <u>294</u> Well depth: <u>294</u> Well grouted to a depth of <u>10</u> feet				
Type of grout (circle one): Cement Bentonite Mix				
Casing length: 284_feet Casing diameter: _2inches Type of casing:				
Screen length:				
Screen slot size:				
Type of completion (circle all applicable): Gravel packed Underreamed Telescoped Open hole Natural Development				
Other (describe):				
Top of lap pipe or reduction in casing: <u>NA</u> feet. If telescoped or more than one screen, describe on back of page				
Logs run (circle all applicable) No log run Electric Gamma Ray Density Sonic Neutron Other:				
Name of organization running log(s): NIA I certify that the well was drilled, constructed, and completed in accordance with all applicable requirements of the Mississippi				
Department of Environmental Quality and/or the Mississippi Department of Health-regulations and state laws.				
JUCKKIdgdell U-472 Jul Milfall				
Print Name of Water Well Contractor and License No.				
	<u> </u>	- LULIVED		

•

JUL 2 5 2006 BY: OLWR

K-515

If well telescopes please sketch below and show depths.

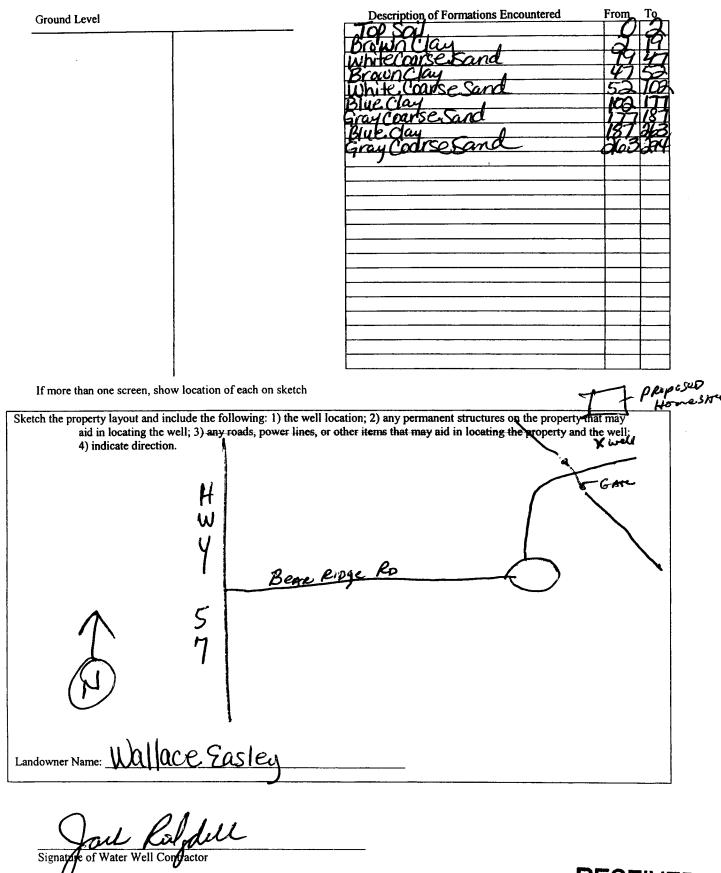

RECEIVED

JUL 2 5 2006 BY: OLWR

STATE WELL REPORT				
County: Jackson Permit #: Driller: Coast Water WellS VP Date completed: (2-20-06	Part 2 Pump Installer's Completion Report Mississippi Department of Environmental Quality Office of Land and Water Resources P.O. Box 10631 Jackson, MS 39289-0631 (601)961-5210 (601)354-6938 (fax)		For Office Use Only: Aquifer: Well #:	
This report should be prepared by the pump installer in detail and filed with the Department within 30 days of the installation of pump.				
Weil Owner Informat	tion Well La		ll Location	
Owner Name: Wallace Eag Mailing Address: Bear Ridge	e Rd.	Latitude: <u>30° 30' 769</u> ^t Longitude: <u>088° 41' 65</u> <u>46</u> Method of Lat/Long (circle one): Conventional Survey, USGS quad, (Hand-held GPS) Survey-grade GPS		
Vancleave IW City State Telephone No. (228) 219-2535	-	NW NW NW Sec Z1 Twn_T65 Rng R 7W Distance Direction Nearest Town IN Miles of Nawcleague		
			wer Type	
Pump Type Circle one			Sircle one	
Air Lift Jet	Submersible	Diesel Engine Gasolin	ne Engine Natural Gas	
Bucket Piston	Turbine	Electric Motor Hand	Tractor PTO	
Centrifugal Rotary	Flowing Well		(specify):	
Other (specify):		Horse Power Rating of Motor	= <u>2HP</u>	
Date Pump Installed: 6-28-04	Date Pump Installed: 6-28-06 Setting Depth: 80ff Drop Pipe feet		rop Pipe feet	
Rated Pump Capacity: <u>8.6</u>	Gallons Per Minute	Number of Stages:3		
Pump Test Data Method of Measuring Water Level		asuring Water Level		
			Circle one	
Date Well Tested: 6-28-Cle Air Line Electric Measuring Line Steel Tape				
Static Water Level (A): Feet Below Land Surface Pumping Water Level (B): Feet Below Land Surface Other (specify):				
	Drawdown [(B) – (A)]: $\frac{N/A}{A}$ Feet Below Land Surface For flowing well, measured shut in head: $\frac{N/A}{A}$ feet			
Test Pumping Rate: Gallons Per Minute Well yielded GPM with a drawdown of			•	
Duration of Pump Test (minimum 4 hours):	-		WAhours of pumping	
I HEREBY CERTIFY that the above statements are true to the best of my knowledge Jack Ridodell 0-472 Print Name of Pump Installer and License No. (if applicable) Signature of Pump Installer RECEIVEL				

•

JUL 2 5 2006 BY: OLWR