

Part 2 never received 3/13

# State Well Report

## Part 1

Mississippi Department of Environmental Quality  
Office of Land and Water Resources  
P.O. Box 10631  
Jackson, MS 39289-0631  
(601)961-5210  
(601)354-6938 (fax)

### For Office Use Only:

Aquifer: \_\_\_\_\_  
Well #: K-516  
L. S. Elevation: \_\_\_\_\_  
E-log #: \_\_\_\_\_

County: JACKSON  
Permit #: \_\_\_\_\_  
Driller: Coast Water Works  
Date drilling completed: 6-21-06

State Law requires that this report be prepared by the driller in detail and filed with the Department within 30 days of completion of drilling of the well.

Well Owner Information	Well Location
Owner Name: <u>Clint Davis</u>	Latitude: <u>30° 30' 10.4" N</u> Longitude: <u>88° 45' 56.7" W</u>
Mailing Address: <u>Humphrey Rd.</u>	Method of Lat/Long (circle one): <u>Conventional Survey</u>
<u>Vancleave Ms. 39565</u>	USGS quad: <u>(Hand-held GPS)</u> Survey-grade GPS
City State Zip Code	<u>NW 1/4 NW 1/4 Sec 30 Twn 76S Rng 7W</u>
Telephone No. <u>(228)-327-</u>	Distance Direction Nearest Town
	<u>2 Miles SW of Vancleave</u>

### Well Data

Purpose of Well (circle one) Home Industrial Public Supply Irrigation Fish Culture Other: \_\_\_\_\_

Date well drilling started: 6-21-06 Date well drilling completed: 6-21-06

If flowing, method of flow regulation: Valve N/A Other (describe) \_\_\_\_\_

Static Water Level: 40 feet above of below (circle one) land surface Date measured: 6-21-06

Method of Measurement (circle one) steel tape electric tape air line other: \_\_\_\_\_

Hole depth: 150' Well depth: 150' Well grouted to a depth of 10 feet

Type of grout (circle one): Cement Bentonite Mix

Casing length: 140 feet Casing diameter: 2 inches Type of casing: PVC

Screen length: 10 feet Screen diameter: 2 inches Type of screen: PVC

Screen slot size: .006 inches Setting depth: From 140 feet to 150 feet

Type of completion (circle all applicable): Gravel packed Underreamed Telescoped Open hole Natural Development

Other (describe): \_\_\_\_\_

Top of lap pipe or reduction in casing: \_\_\_\_\_ feet. If telescoped or more than one screen, describe on back of page

Logs run (circle all applicable): No log run Electric Gamma Ray Density Sonic Neutron Other: \_\_\_\_\_

Name of organization running log(s): N/A

I certify that the well was drilled, constructed, and completed in accordance with all applicable requirements of the Mississippi Department of Environmental Quality and/or the Mississippi Department of Health regulations and state laws.

Jack Ridgwell 0-472  
Print Name of Water Well Contractor and License No.


Jack Ridgwell  
Signature of Water Well Contractor

RECEIVED  
JUL 25 2006  
BY: OLWR

K-516


If well telescopes please sketch below and show depths.


Ground Level

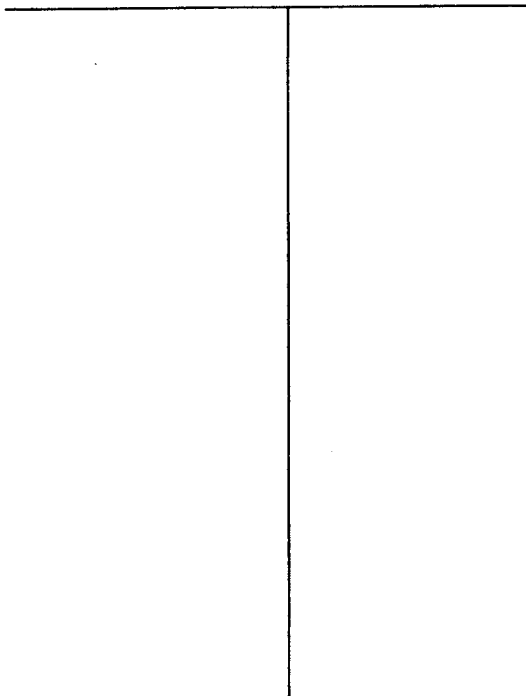

Description of Formations Encountered	From	To
TOP SOIL	0	2
Brown clay	2	17
White coarse sand	17	38
Blue clay	38	115
medium gray sand	115	150

If more than one screen, show location of each on sketch

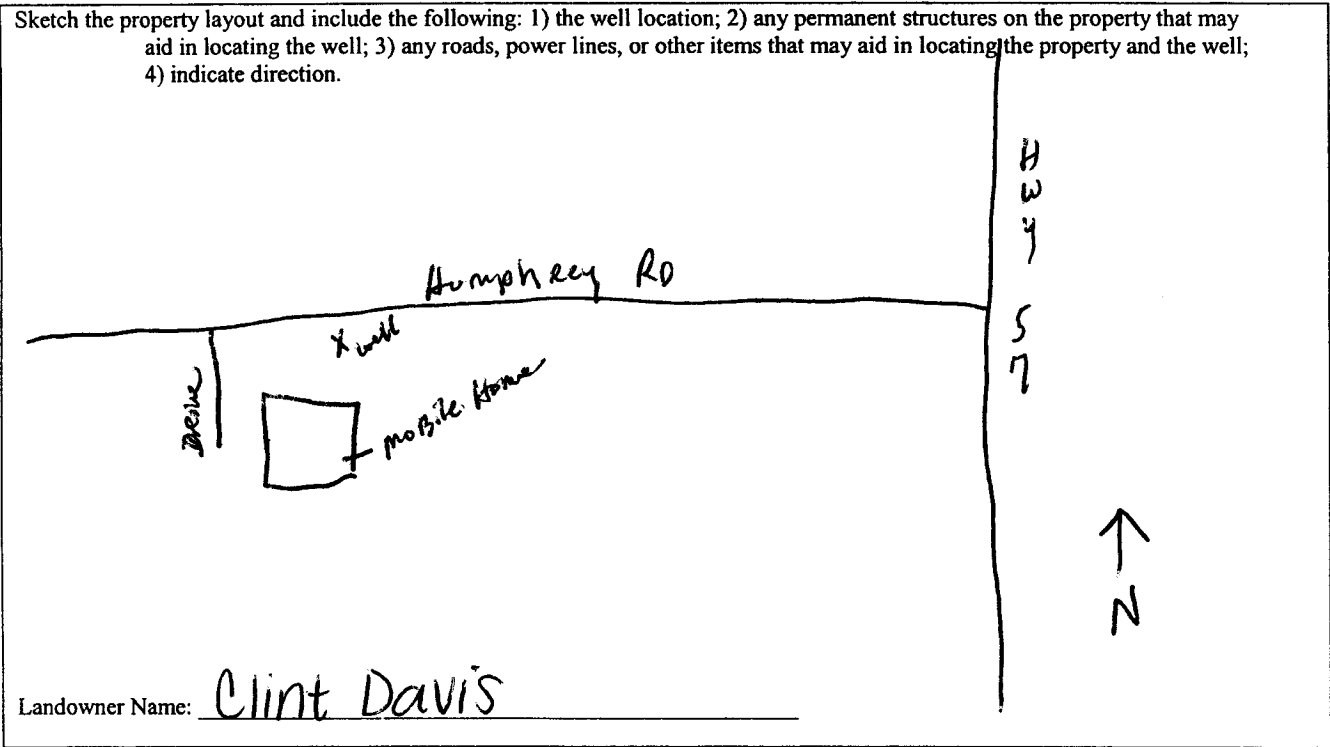

  
Signature of Water Well Contractor

**RECEIVED**  
JUL 25 2006  
**BY: OLWR**