

State Well Report

Part 1

Mississippi Department of Environmental Quality
Office of Land and Water Resources
P.O. Box 10631
Jackson, MS 39289-0631
(601)961-5210
(601)354-6938 (fax)

For Office Use Only:

Aquifer: _____
Well #: K-527
L. S. Elevation: _____
E-log #: _____

County: Jackson
Permit #: _____
Driller: Coast Water Wells, Inc.
Date drilling completed: 9-8-06

State Law requires that this report be prepared by the driller in detail and filed with the Department within 30 days of completion of drilling of the well.

Well Owner Information	Well Location
Owner Name: <u>Ralph King Construction</u>	Latitude: <u>30° 29' 25"</u> Longitude: <u>088° 39' 28"</u>
Mailing Address: <u>Clearwater Rd.</u>	Method of Lat/Long (circle one): Conventional Survey, <u>14</u>
<u>Vanderve MS 39565</u>	USGS quad: <u>Hand-held GPS</u> , Survey-grade GPS
City State Zip Code	<u>NW 1/4 NW 1/4 Sec 35 Twn T6 S Rng T7 W</u>
Telephone No. <u>(228) 218-4429</u>	Distance Direction Nearest Town <u>3</u> Miles <u>SE</u> of <u>Vanderve</u>

Well Data

Purpose of Well (circle one) Home Industrial Public Supply Irrigation Fish Culture Other: _____
Date well drilling started: 9-8-06 Date well drilling completed: 9-8-06
If flowing, method of flow regulation: Valve NIA Other (describe) _____
Static Water Level: 20 feet above or below (circle one) land surface Date measured: 9-8-06
Method of Measurement (circle one) steel tape electric tape air line other: _____
Hole depth: 122' Well depth: 122' Well grouted to a depth of 10 feet
Type of grout (circle one): Cement Bentonite Mix
Casing length: 112 feet Casing diameter: 2 inches Type of casing: PVC
Screen length: 10 feet Screen diameter: 2 inches Type of screen: PVC
Screen slot size: .008 inches Setting depth: From 112 feet to 122 feet
Type of completion (circle all applicable): Gravel packed Underreamed Telescoped Open hole Natural Development
Other (describe): _____
Top of lap pipe or reduction in casing: _____ feet. If telescoped or more than one screen, describe on back of page
Logs run (circle all applicable) No log run Electric Gamma Ray Density Sonic Neutron Other: _____
Name of organization running log(s): NIA

I certify that the well was drilled, constructed, and completed in accordance with all applicable requirements of the Mississippi Department of Environmental Quality and/or the Mississippi Department of Health regulations and state laws.

JACK RIDGDELL 0-472

Print Name of Water Well Contractor and License No.

JACK RIDGDELL RECEIVED
Signature of Water Well Contractor SEP 25 2006

BY: OLWR

K-527


If well telescopes please sketch below and show depths.

Ground Level _____

Description of Formations Encountered	From	To
TOP SOIL	0	2
Red clay	2	13
white coarse sand	13	60
Blue clay	60	85
white coarse sand	85	122

If more than one screen, show location of each on sketch

Sketch the property layout and include the following: 1) the well location; 2) any permanent structures on the property that may aid in locating the well; 3) any roads, power lines, or other items that may aid in locating the property and the well; 4) indicate direction.

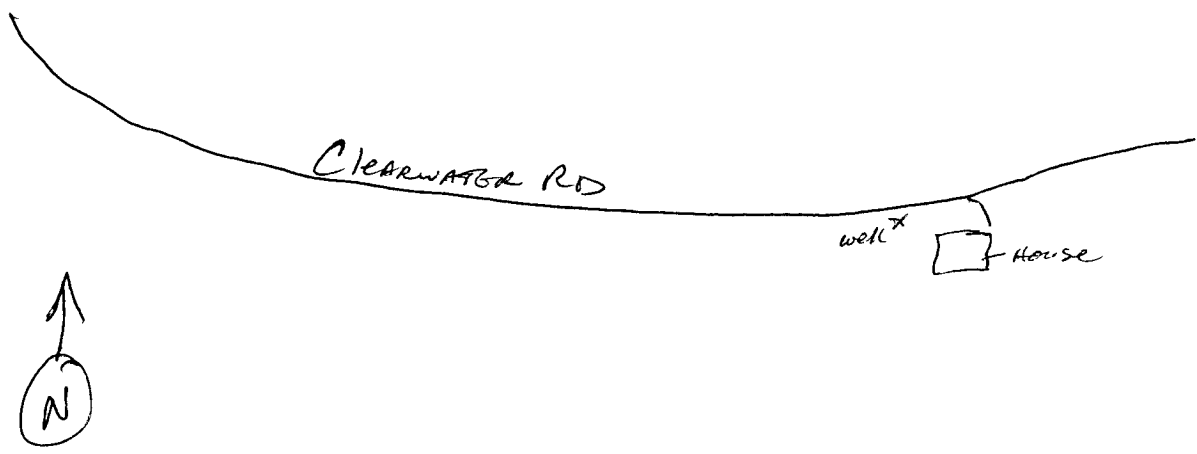

Landowner Name: Ralph King Construction

Joe Ruffolo
 Signature of Water Well Contractor

RECEIVED
 SEP 25 2006
 BY: OLWR

STATE WELL REPORT

Part 2

Pump Installer's Completion Report
 Mississippi Department of Environmental Quality
 Office of Land and Water Resources
 P.O. Box 10631
 Jackson, MS 39289-0631
 (601)961-5210
 (601)354-6938 (fax)

County: Jackson
 Permit #: _____
 Driller: Coastwater
 Date completed: 9-8-06

For Office Use Only:

Aquifer: _____
 Well #: K-527
 Elevation: _____

This report should be prepared by the pump installer in detail and filed with the Department within 30 days of the installation of pump.

Well Owner Information	Well Location
Owner Name: <u>Ralph King Construction</u>	Latitude: <u>30°29'24.5"</u> Longitude: <u>088°39'92.8"</u>
Mailing Address: <u>Clearwater Rd.</u>	Method of Lat/Long (circle one): Conventional Survey,
<u>Vanceleave, MS 39565</u>	USGS quad, <u>(Hand-held GPS)</u> Survey-grade GPS
City State Zip Code	<u>NW 1/4 NW 1/4 Sec 35 Twn T6S Rng R7W</u>
Telephone No. <u>228 218-4429</u>	Distance Direction Nearest Town
	<u>3 Miles SE of Vanceleave</u>

Pump Type Circle one	Power Type Circle one
Air Lift <input type="radio"/> Jet <input checked="" type="radio"/> Submersible	Diesel Engine Gasoline Engine Natural Gas
Bucket <input type="radio"/> Piston <input type="radio"/> Turbine	<input checked="" type="radio"/> Electric Motor <input type="radio"/> Hand <input type="radio"/> Tractor PTO
Centrifugal <input type="radio"/> Rotary <input type="radio"/> Flowing Well	Windmill Other (specify): _____
Other (specify): _____	Horse Power Rating of Motor: <u>1HP</u>
Date Pump Installed: <u>9-12-06</u>	Setting Depth: <u>40FT. Drop pipe</u> feet
Rated Pump Capacity: <u>9</u> Gallons Per Minute	Number of Stages: <u>2</u>

Pump Test Data	Method of Measuring Water Level Circle one
Date Well Tested: <u>9-12-06</u>	<input checked="" type="radio"/> Air Line <input type="radio"/> Electric Measuring Line <input type="radio"/> Steel Tape
Static Water Level (A): <u>20</u> Feet Below Land Surface	Other (specify): _____
Pumping Water Level (B): <u>N/A</u> Feet Below Land Surface	For flowing well, measured shut in head: <u>N/A</u> feet
Drawdown [(B) - (A)]: <u>N/A</u> Feet Below Land Surface	Well yielded <u>9</u> GPM with a drawdown of
Test Pumping Rate: <u>9</u> Gallons Per Minute	<u>N/A</u> feet after <u>N/A</u> hours of pumping
Duration of Pump Test (minimum 4 hours): <u>4</u> hours	

RECEIVED

I HEREBY CERTIFY that the above statements are true to the best of my knowledge.

Jack Ridgell 0-472 SEP 25 2006
 Print Name of Pump Installer and License No. (if applicable) BY: OLWR

Jack Ridgell
 Signature of Pump Installer