State W	ell Report					
	Part 1 For Office Use Only:					
Mississippi Departmen	t of Environmental Quality Aquifer:					
	and Water Resources Box 10631 Well #: <u>K-544</u>					
	IS 39289-0631 L. S. Elevation:					
	961-5210 4-6938 (fax) E-log #:					
	deiller is detail and filed with the Department within					
State Law requires that this report be prepared by the 30 days of completion of drilling of the well.	driller in detail and filed with the Department within					
Well Owner Information	Well Location					
Owner Name Greg McMillan	Latitude: <u>30 • 33 · 409</u> " Longitude: <u>086• 48 · 484</u> " <b>29</b> Method of Lat/Long (circle one): Conventional Survey,					
Mailing Address: MONT CIIFF Rd	Method of Lat/Long (circle one): Conventional Survey,					
	USGS quad, Hand-held GPS, Survey-grade GPS					
Vancleave, MS 39545 City State Zip Code	NE 1/ NE 1/ Sec / Twn T65 Rng R7 W					
Telephone No. (28) 8210-51052	Distance Direction Nearest Town <u>3/2 Miles ENE of VAncleane</u>					
Well ]	Data					
Purpose of Well (circle one) Home Industrial Public Supply	Irrigation Fish Culture Other:					
Date well drilling started: $1 - 23 - 01$ Date w						
If flowing, method of flow regulation: Valve NIA Other (d						
Static Water Level: 105 feet above or below (circle one) I						
Method of Measurement (circle one) steel tape electric tape	air line other:					
Hole depth: <u>23</u> Well depth: <u>33</u>	Well grouted to a depth offeet					
Type of grout (circle one): Cement Bentonite Mix						
Casing length: <u>198</u> feet Casing diameter: <u>2</u>	_inches Type of casing:					
Screen length: 15 feet Screen diameter: 2 inches Type of screen: OVC						
Screen slot size:						
Type of completion (circle all applicable): Gravel packed Underreamed Telescoped Open hole (Natural Development)						
Other (describe):						
Top of lap pipe or reduction in casing:feet. If telescoped or more than one screen, describe on back of page						
Logs run (circle all applicable): No log run Electric Gamma Ray Density Sonic Neutron Other:						
Name of organization running log(s): N/A						
I certify that the well was drilled, constructed, and completed in a Department of Environmental Quality and/or the Mississippi Dep						
	arcineur or nearco regulations and state laws.					
Tack Ridgolell 0-472	_ Joup hit ful					
Print Name of Water Well Contractor and License No.	Signature of Water Well Contractor					

.

FOR IS 202 BY OLM B


K-544

If well telescopes please sketch below and show depths.

Ground Level

Description of Formations Encountered	From	To A
prance clay Brown coarse sand	15 15	15 58 79
Blue Clay Gray Fine Sand	-79 -196	196 213

If more than one screen, show location of each on sketch

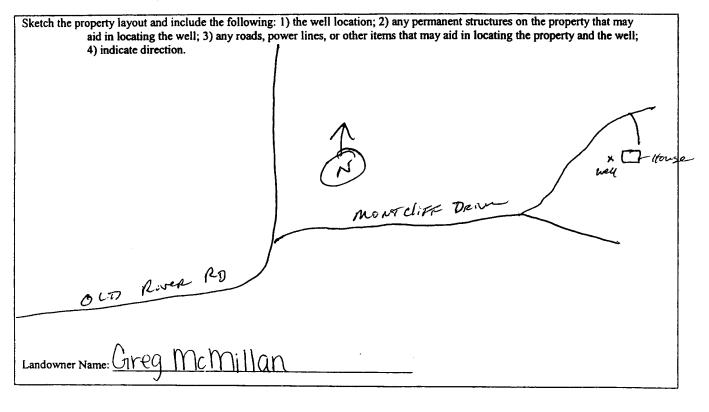

fue Signature of Water Well Contractor

The second secon FEB 0 8 2007 BY OLWR

Tarkenn		JINE W	ELL REPORT			
County: JACKSDN Permit #: Driller: Oast Water We Date completed: 1-23-	<u>ells</u> rv.	Pump Installer Mississippi Departme Office of Land P.O. Jackson, (601) (601)3	For Office Use Only: Aquifer: Well #: <u>K-544</u> Elevation:			
This report should be pro installation of pump.	epared by th	e pump installer in det	ail and filed with the Departme			
Well Owner Information			-	ll Location		
Owner Name: Greg McMillan Mailing Address: Mont Cliff Bd			Latitude: 2033 409"	_Longitude: <u>088° 48'484</u> <b>29</b>		
			Method of Lat/Long (circle one): Conventional Survey,			
			USGS quad, Hand	I-held GPS, Survey-grade GPS		
Nancieniems 39505				Twn T65 Rng R7W		
Vancleaverms 39505 City State Zip Code			Nearest Town			
Telephone No. (228)8210-5452		<u>31/2</u> Miles <u>ENE</u> o				
Telephone No. (2018) 00 U		<u></u>	<u>JIC</u> Miles <u>ENE</u> 0	۲ <u></u>		
Ритр Туре			wer Type			
Ci	ircle one		C	ircle one		
Air Lift (Jet)		Submersible	Diesel Engine Gasolin	e Engine Natural Gas		
Bucket Pisto	n	Turbine	Electric Motor Hand	Tractor PTO		
Centrifugal Rota	ry	Flowing Well	Windmill Other (	(specify):		
Other (specify):			Horse Power Rating of Motor:	2HP		
Date Pump Installed: 1-20	Date Pump Installed: 1-24-07			Setting Depth: 120 Ft. drup Dipe feet		
Rated Pump Capacity: 7, 5 Gallons Per Minute			Number of Stages:3			
Pump Test Data				asuring Water Level		
Date Well Tested:			rcle one			
Static Water Level (A): 105 Feet Below Land Surface			suring Line Steel Tape			
Pumping Water Level (B): NA Feet Below Land Surface		Other (specify):				
Drawdown [(B) – (A)]:A Feet Below Land Surface			For flowing well, measured shi	ut in head: <u>NIA</u> feet		
Test Pumping Rate: 7,5 Gallons Per Minute			Well yielded GPM with a drawdown of			
Duration of Pump Test (minimum 4 hours): hours			NIAfeet after			

 $\mathcal{T}$ 

• \* \*

.

ABBBAN BY: OLWA