	Vell Report	For Office Use Only:	
	Part 1		
	nt of Environmental Quality and Water Resources	Aquifer:	
(mothinterribilsal P.O.	Office of Land and Water Resources P.O. Box 10631 Well #: K-598		
	Jackson, MS 39289-0631 L. S. Elevation:		
	(601)961-5210 (601)354-6938 (fax) E-log #:		
State Law requires that this report be prepared by the driller in detail and filed with the Department within			
30 days of completion of drilling of the well.			
Well Owner Information		Location	
Owner Name Ellen Matthews	Latitude: <u>30° 31 °0/7</u>	50	
Mailing Address: MONNINGED (Conventional Survey, Method of Lat/Long (circle one): Conventional Survey,			
		GPS) Survey-grade GPS	
Vancleave. MS 39565 City State Zip Code	<u>Sw 1/2 5 w 1/2 Sec 17</u>	Twn T65 Rng R7W	
Telephone No. 208 990 - 7806	Distance Siochini 1/4 Miles	Nearest Town of VAnclean	
Weil	Data		
Purpose of Well (circle one) Home Industrial Public Supply Irrigation Fish Culture Other:			
Date well drilling started: $3 - 12 - 08$ Date well drilling completed: $3 - 12 - 08$			
If flowing, method of flow regulation: Valve NA Other (describe)			
Static Water Level: <u>80</u> feet above or below circle one) land surface Date measured: <u>2-12-08</u>			
Method of Measurement (circle one) steel tape electric tape (air line) other: RECEN			
Hole depth: <u>325 FT</u> Well depth: <u>325 FT</u> Well grouted to a depth of <u>10</u>			
Hole depth: 335 FT Well depth: 335 FT Well grouted to a depth of 10 MAR 0 6 2008 Type of grout (circle one): Cement Bentonite Mix 87.0208 Casing length: 315 feet Casing diameter: ainches Type of casing: PVC			
Casing length: <u>315</u> feet Casing diameter: <u>3</u>	inches Type of casing:	PVC ULWA	
Screen length: 10 feet Screen diameter: 2 inches Type of screen: PVC			
Screen slot size: +002 inches Setting depth: From 315 feet to 325 feet			
Type of completion (circle all applicable): Gravel packed Under	rreamed Telescoped Open	hole Natural Development	
Other (describe):			
Top of lap pipe or reduction in casing: MA feet. If telescoped or more than one screen, describe on back of page			
Logs run (circle all applicable) No log run Electric Gamma Ray Density Sonic Neutron Other:			
Name of organization running log(s): NA			
I certify that the well was drilled, constructed, and completed in accordance with all applicable requirements of the Mississippi Department of Environmental Quality and/or the Mississippi Department of Health regulations and state laws.			
Ticilia a			
Jack Kidgdell U-472	tack p	il fall	
Print Name of Water Well Contractor and License No.	Signature of	Water Well Contractor	

K- 598


If well telescopes please sketch below and show depths.

Ground Level

•

 Description of Formations Encountered	From	T₀ 72
Prown coarse sand Prange + white Clay Brown Coarse sand	78	1200
Blue Clay Gray Course sand	155 341	277 323

If more than one screen, show location of each on sketch

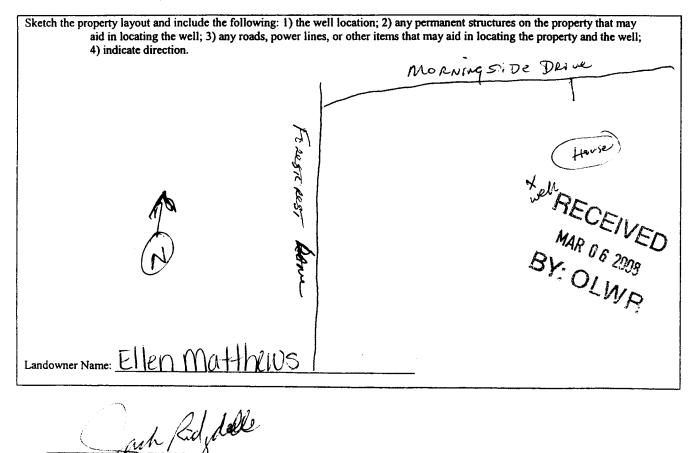

Signature of Water Well Contractor

STATE WELL REPORT		
County: <u>JACKSOV</u> Permit #: <u>Office of Land</u> Driller: <u>CASEWATENGEUSEN</u> Date completed: <u>2-12-08</u> Pump Installer' Mississippi Departmen Office of Land P.O. Jackson, M (601)	art 2 For Office Use Only: s Completion Report Aquifer: and Water Resources Main Sector Box 10631 Mell #: AS 39289-0631 Well #: 9961-5210 Elevation: 64-6938 (fax) Siled with the Department within 30 days of the	
This report should be prepared by the pump installer in deta installation of pump.	in and ned with the Department within 55 days of the	
Well Owner Information Owner Name: Ellen MATTHEWS Mailing Address: MORNINGSIDE DR.	Thews Latitude: 30° 31' 017" Longitude: 088° 42' 839' DR. Method of Lat/Long (circle one): Conventional Survey,	
Varclenere 45 - 39565 City Stote Zip Code Telephone No. (208) 990 - 7806	USGS quad, Hand-held GPS, Jurvey-grade GPS <u>SW 14 5W 14 Sec 17</u> Twn 765 Rng R 7W Distance Direction Nearest Town <u>114</u> Miles <u>WBT</u> of <u>VAnclemme</u>	
Pump Type Circle one Air Lift (Jet Submersible	Power Type Circle one Diesel Engine Gasoline Engine Natural Gas	
Bucket Piston Turbine	Electric Motor Hand Tractor PTO	
Centrifugal Rotary Flowing Well Other (specify):	Windmill Other (specify): Horse Power Rating of Motor: Image:	
Pump Test Data	Method of Measuring Water Level	
Pump Test Data Date Well Tested: $3-3-88$ Static Water Level (A): $80'$ Feet Below Land Surface Pumping Water Level (B): N/A Feet Below Land Surface Drawdown [(B) - (A)]: N/A Feet Below Land Surface Test Pumping Rate: 9.5 Gallons Per Minute Duration of Pump Test (minimum 4 hours): 4 hours	Air Line Electric Measuring Line Steel Tape Other (specify):	
I HEREBY CERTIFY that the above statements are true to the best of my knowledge. TALK Rio 6 pe 1 0-472 Print Name of Pump Installer and License No. (if applicable) Signature of Pump Installer APR 0 8 2008 BY: OLWF		

.