
	State Well Report	For Office Hee Only		
County: Tackson Missian	Part 1	For Office Use Only:		
1 1/11/15/15/5	ippi Department of Environmental Quality	Aquifer:		
	Office of Land and Water Resources	Well #: K-607		
Driller Cost Water Wells RV.	P.O. Box 10631 Jackson, MS 39289-0631	L. S. Elevation:		
Date drilling completed: 4-24-08	(601) 961-5210	L. S. Elevation:		
Date drilling completed: _1 &-1 &-3	(601) 354-6938 (fax)	E-log #:		
State Law requires that this report be pr	repared by the driller in detail and filed	with the Department within		
30 days of completion of drilling of the w	veli.	ell Location		
Owner Name Doug Gaston		3, Longitude <u>(%) 42, 330</u> ,		
Mailing Address: TIMORUMSEY R		/ /9		
		d GPS, Survey-grade GPS		
Vancleave Ms 39	$\frac{NW_{1/4}SE}{\text{Zip Code}}$ $\frac{NW_{1/4}SE}{\text{X Sec}}$ $\frac{8}{8}$	Twn T 65 Rng R 7W		
City State Telephone No. (208) 348 - 1729	Distance Direction A Miles WW	of Marclesve		
Total Control				
	Well Data			
Purpose of Well (circle one Home Industrial	Public Supply Irrigation Fish Culture	Other:		
Date well drilling started: 4-83-68	Data mall deilling assemblated.	-DU-CR		
	. 1			
If flowing, method of flow regulation: ValveOther (describe)				
Static Water Level: 95 feet above or felow (circle one) land surface Date measured: 4-24-08				
Method of Measurement (circle one) steel tape electric tape air line other:				
Hole depth: 315 FT Well depth: 315 FT Well grouted to a depth of 10 feet				
Type of grout (circle one): Cement Benton	Mix Mix			
Casing length: 305 feet Casing diameter:inches Type of casing:				
Screen length:feet		PUC		
Screen slot size:, WW_inches Setting depth: From				
Type of completion (circle all applicable): Gravel packed Underreamed Telescoped Open hole Natural Development				
x /	describe):			
Top of lap pipe or reduction in casing: NA feet. If telescoped or more than one screen, describe on back of page				
Logs run (circle all applicable): No log run Electri	c Gamma Ray Density Sonic Neutron	Other:		
Name of organization running log(s): NA I certify that the well was drilled, constructed, and	d completed in accordance with all applicable	e requirements of the Mississippi		
Department of Environmental Quality and/or the				
Jack Ridadell 0-47	a land	Relder		
Print Name of Water Well Contractor and License N	o. Signature of	f Water Well Contractor		
	<i>U</i>	BECEIVE		
		and the state of t		

		•
If weil telescopes please sketch below and show depths.		
Ground Level	Description of Formations Encountered	From To
Ground Level	TOPSOIL	
	orange Clay	18 3
·	proportions Santa	2010
	Brown Coarse Sand	105 14
	Blue clay	145 29
	Gray Medium Sand	5923
		
		
	4.00	
l		
If more than one screen, show location of each on sketch		
etch the property layout and include the following: 1) the we	ell location: 2) any permanent structures on the property	that may
aid in locating the well, 3) any roads, power lines	s, or other items that may aid in locating the property an	d the well;
4) indicate direction.	s, or other items that may aid in locating the property an	1
/	i je ^g a /	1
18	م المحمد	1
18, 21	4. 13° /w	14

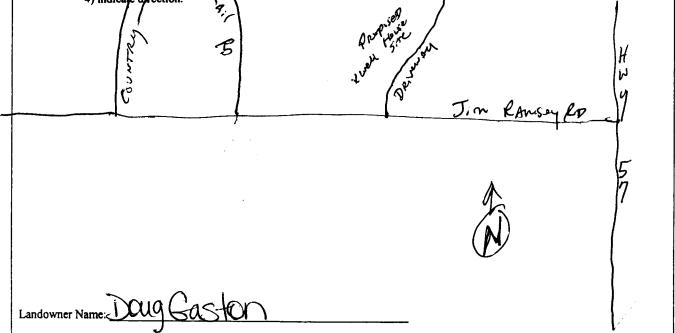

Signature of Water Well Contractor

RECEIVED

MAY 14 2008

BY: OLWR

STATE WELL REPORT

Permit #: Drille Cast Wher Well SKV. Date completed: 4-24-08

Part 2

Pump Installer's Completion Report
Mississippi Department of Environmental Quality
Office of Land and Water Resources
P.O. Box 10631

P.O. Box 10631 Jackson, MS 39289-0631 (601)961-5210 (601)354-6938 (fax)

For Office Use Only:			
Aquifer:			
Well #: K-607			
Elevation:			

Date completed: 4-24-08		54-6938 (fax)	Elevation:		
This report should be prepared by the pump installer in detail and filed with the Department within 30 days of the installation of pump.					
Well Owner Informat	ion	Well Location			
Owner Name: Doug Gaston		Latitude 30 32' 123"	_ Longitude: <u>088° 42′ 32</u> 0 ¹⁴		
Mailing Address: Jim Ramsey Rd		Method of Lat/Long (circle one): Conventional Survey,			
		USGS quad, Hand-held GPS Survey-grade GPS			
Vancleave Ms	39565 Zip Code		7 Twn <u>765</u> Rng <u>R7W</u>		
		Distance Direction	Nearest Town		
Telephone No. (<u>208)</u> <u>348 – 1729</u>					
		<u></u>			
Pump Type Circle one			wer Type Circle one		
Air Lift Jet	Submersible	Diesel Engine Gasolii	ne Engine Natural Gas		
Bucket Piston	Turbine	Electric Motor Hand	Tractor PTO		
Centrifugal Rotary	Flowing Well	Windmill Other	(specify):		
Other (specify):		Horse Power Rating of Motor: 2 HP			
Date Pump Installed: 5-19-08		Setting Depth: 120 FT. Drop pipe feet			
Rated Pump Capacity: 9	Gallons Per Minute	Number of Stages:	3		
Pump Test Data		Mathad of Ma			
· ·		Method of Measuring Water Level Circle one			
Date Well Tested: 5-19-08		Air Line Electric Mea	suring Line Steel Tape		
Static Water Level (A): 95 Feet F	Below Land Surface		suring Line Steel Tape		
Pumping Water Level (B):Feet Below Land Surface		Other (specify):			
Drawdown [(B) – (A)]: N A Feet E		For flowing well, measured sh	ut in head: N/A feet		
Test Pumping Rate: 9	Gallons Per Minute	Well yielded Z0	_GPM with a drawdown of		
Duration of Pump Test (minimum 4 hours):	5 hours	NA feet after	NA hours of pumping		
					

ľ			
	TOLO EIKINS O-7168	of my knowledge.	CEIVED
	Print Name of Pump Installer and License No. (if applicable)	Signature of Pump Installer	BEC 2008
		•	IUNTS

BY: OLWR